


Section 10 Township 17 Range 12-W

Well No. #1 Bloomer

Company Duke & Wood

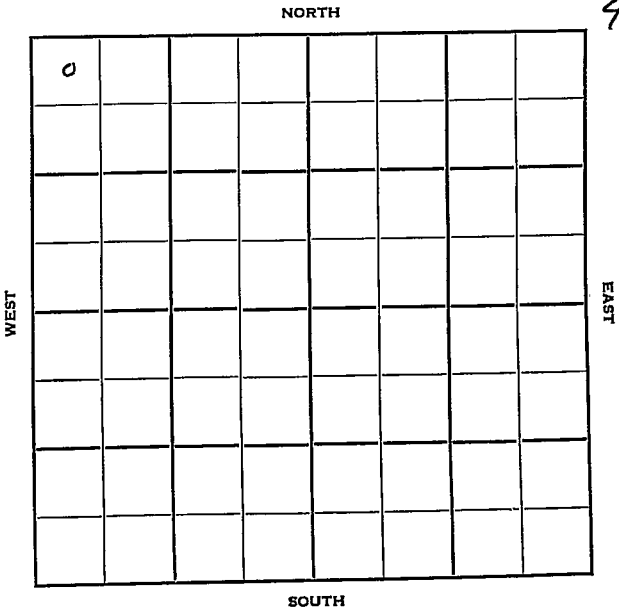

Barton
17

KANSAS 12W ✓

Sec. 10 Twp. 17 R. _____

Well No. #1 Bloomer Farm

Duke & Wood Company

Odin Contractor


330' Ft. from N. Line

Ft. from S. Line

Ft. from E. Line

330' Ft. from W. Line

NW NW NW

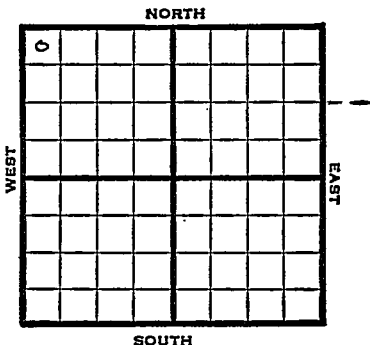

1950

?

REPORT

5/24

Spud 5-20-50
8" @ 227'
Anhy 530-60'
Drlg. 1160'

6/21

TD 3312
8" @ 227
Anhy 530-60
KC 3050
5" @ 3311
250 acid
15 boph
500 acid
2 boph
1000 acid
HFW
PB 3060
20/3055-59
1000 acid
D&A

Heeb 2947
Arb 3310-12

ABANDONED

Odin

Kansas

Map No. _____ Sec. 10 Twp. 17 R. 12W

Well No. 1 Bloomer

Duke & Wood _____ Company

Contractor

NW NW NW

SECTION PLAT

330 Ft. from N. Line

_____ Ft. from S. Line

_____ Ft. from E. Line

330 Ft. from W. Line

o			
FIRST REPORT			

Barton

Location _____

Rig up _____

Drilling and Remarks: .

Spud 5-20-50

8" @ 227

Anhy 530-60

Drlg. 1160

RECORD

Cased _____ in., _____ ft.

Sand _____

Gas _____

Oil _____

Total Depth _____

PRODUCTION

1st 24 hrs. Nat. _____

1st 24 hrs. after shot _____

Gas _____ Cu. Ft.

Dry Hole _____

Abandoned _____

Date

MAY 24 1950

19

J. E. TYRA Scout

Kansas

Map No. _____ Sec. 10 Twp. 17 R. 12WWell No. 1 BloomerDuke & Wood

Company

Contractor


NW NW NW

SECTION PLAT

330 Ft. from N. Line

_____ Ft. from S. Line

_____ Ft. from E. Line

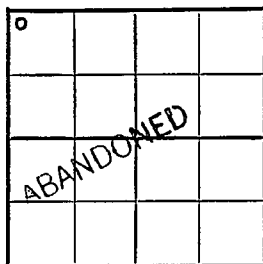330 Ft. from W. LineBarton County

Location _____

Rig up _____

Drilling and Remarks:

8" @ 227

Anhy 530-60

Heeb. 2947

KC 3050

Arb. 3310-12

5" @ 3311

RECORD

Cased _____ in., _____ ft.

Sand _____

Gas _____

Oil _____

Total Depth 3312

PRODUCTION

1st 24 hrs. Nat. _____

1st 24 hrs. after shot _____

Gas _____ Cu; Ft.

Dry Hole _____

Abandoned _____

Date

JUN 21 19J. E. TYRA

Scout

TD 3312

250 acid

15 boph

500 acid

2 boph

1000 acid

HFW

PB 3060

20/3055-59

1000 acid

D & A

Scout-Cards
Land Small Map
Land Wall Map
Tracings
France Map
Pierce Map
Misc.

[Handwritten initials and a large checkmark are present over the table.]

JUN 29 1950
