


Butler

FORM 51 IOM 12-46 PETROL

Section 30 Township 29 Range 8E

Well No. 1 Shinn

Company Sam Springer

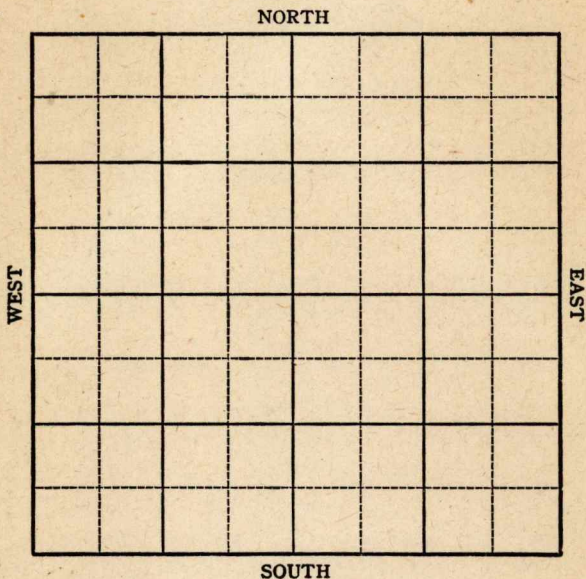

KANSAS

Butler County



Sec. 30 Twp. 29 R. 8E

Well No. 1 Shinn Farm  
Sam Springer Company


Miscellaneous

\_\_\_\_\_ Ft. from N. Line

\_\_\_\_\_ Ft. from S. Line

\_\_\_\_\_ Ft. from E. Line

\_\_\_\_\_ Ft. from W. Line

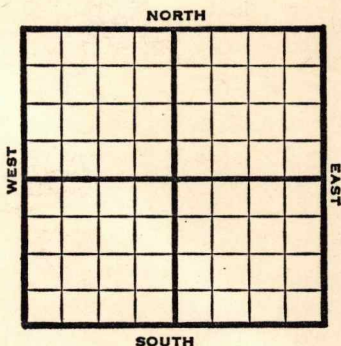

NW/C Lot 17

1947

REPORT

5/28 Drlg. 1200'

6/3 Miss 2680-2718  
TD Run D

6/10 5" @ 2718'  
TD 2730'  
1000 Acid.

6/18 Miss. 2680'  
5" @ 2718'  
TD 2730'

ABANDONED

Map No. \_\_\_\_\_ Sec. 30 Twp. 29 R. 8E

Well No. 1 Shinn

Sam Springer Company

FIRST REPORT Contractor

NW/C Lot 17

SECTION PLAT

\_\_\_\_\_ Ft. from N. Line

\_\_\_\_\_ Ft. from S. Line

\_\_\_\_\_ Ft. from E. Line

\_\_\_\_\_ Ft. from W. Line


Butler County

Location \_\_\_\_\_

Rig up \_\_\_\_\_

Drilling and Remarks:

1200

RECORD

Cased \_\_\_\_\_ in., \_\_\_\_\_ ft.

Sand \_\_\_\_\_

Gas \_\_\_\_\_

Oil \_\_\_\_\_

Total Depth \_\_\_\_\_

PRODUCTION

1st 24 hrs. Nat. \_\_\_\_\_

1st 24 hrs. after shot \_\_\_\_\_

Gas \_\_\_\_\_ Cu. Ft.

Dry Hole \_\_\_\_\_

Abandoned \_\_\_\_\_

Date

MAY 28 1947

19

S. J. LEWIS

Scout

Map No. 10 Sec. 30 Twp. 29 R. 8E

Well No. 1 Shinn

Sam Springer Company

**ABANDONED**

Contractor

NW/c Lot 17

SECTION PLAT

\_\_\_\_\_ Ft. from N. Line

\_\_\_\_\_ Ft. from S. Line

\_\_\_\_\_ Ft. from E. Line

\_\_\_\_\_ Ft. from W. Line


Butler County

Location \_\_\_\_\_

Rig up \_\_\_\_\_

Drilling and Remarks:

*Miss 2680  
3" @ 2718*

RECORD

Cased \_\_\_\_\_ in., \_\_\_\_\_ ft.

Sand \_\_\_\_\_

Gas \_\_\_\_\_

Oil \_\_\_\_\_

Total Depth 2780

PRODUCTION

1st 24 hrs. Nat. \_\_\_\_\_

1st 24 hrs. after shot \_\_\_\_\_

Gas \_\_\_\_\_ Cu. Ft.

Dry Hole \_\_\_\_\_

Abandoned \_\_\_\_\_

Date

JUN 1 8 1947 19 S. J. LEWIS Scout