


Section 30 Township 29 Range 8E

Well No. #1 Shinn

Company Springer & Spoor

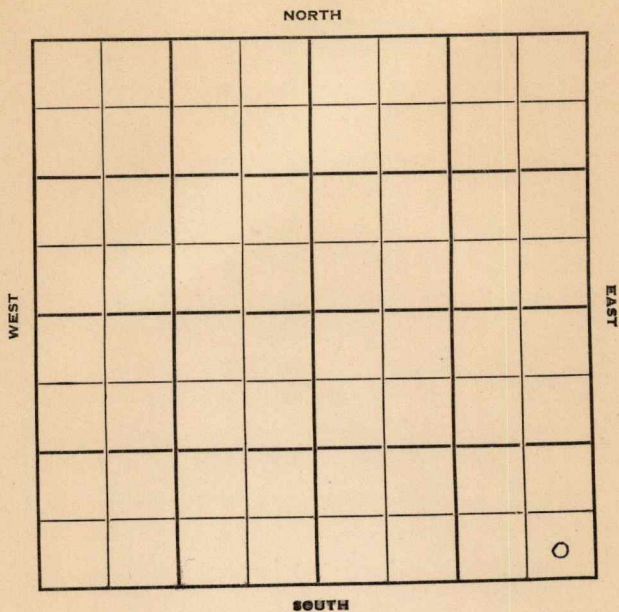

Butler

KANSAS

Sec. 30 Twp. 29 R. 8E ✓

Well No. #1 Shinn Farm

Springer & Spoor Company

Westmore Drlg. - Contr. Contractor

Wildcat


         Ft. from N. Line

330' Ft. from S. Line

330' Ft. from E. Line

         Ft. from W. Line

SE SE SE

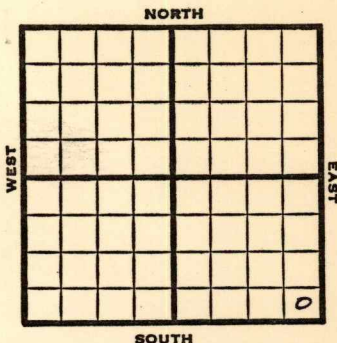

1951

Elev. - REPORT

8/15

Miss 2691

TD 2721

Rng 5"

9/19

D&A TD 2765

Miss 2691 TD 2765

5" @ 2720

FU 30' oil 12 hr 2000 A

no inc. D&A

**ABANDONED**

County **Butler** State **Kansas**

Sec. 30 (Blk.) 29 (Sur.) 8E Map No.

Operator **Springer & Spoor**

Well No. 1 Farm Shinn

[illegible]

330 Ft. From S Line SE

330 Ft. From E Line Quarter

1st. Report AUG 15 1951

### Completion

Remarks

Westmore Drig. - Contr.

Spudding Date

Drig. Data Wildcat

Miss. 2691 TD 2721 rmg. 5<sup>n</sup>

J. E. TYRA

County Butler State Kansas

Sec. 30 (Blk. Twp.) 29 (Sur. Rge.) 8E Map No.

Operator Springer & Spoor

Well No. 1 Farm Shinn

| Elev. | Location | SE | SE | SE |
|-------|----------|----|----|----|
|-------|----------|----|----|----|

ABANDONED

0

330 Ft. From S Line SE

330 Ft. From E Line Quarter

1st. Report

Completion SEP 19 1951

Remarks Wildcat

Westmore Drlg. - Contr.

Spudding Date \_\_\_\_\_

Drlg. Data      D & A      TD 2765

Miss. 2691 TD 2765 5" @ 2720

FU 30' oil 12 hr. 2000 A no inc.

D &amp; A

J. E. TYRA