


Section 30 Township 29 Range 8E

Well No. 1 Wehrman

Company C.C. Nye

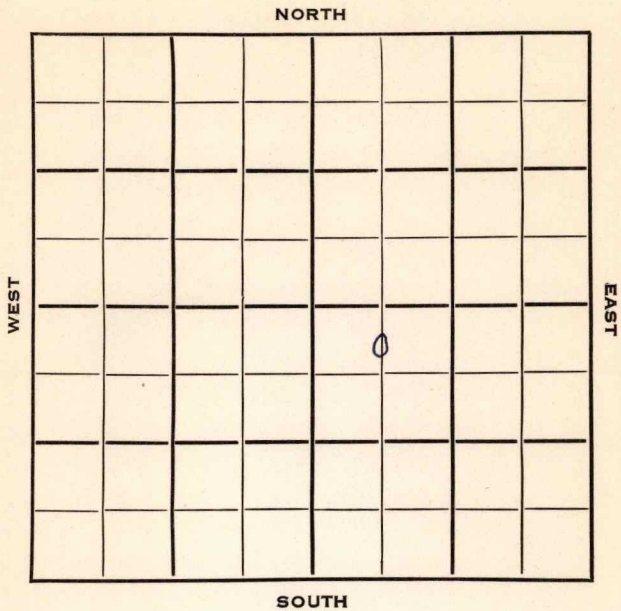

Butler **KANSAS** ✓

Sec. 30 Twp. 29 R. 8E

Well No. #1 Wehrman Farm

C. C. Nye Company

Mendenhall Contractor


330 Ft. from N. Line

_____ Ft. from S. Line

_____ Ft. from E. Line

660 Ft. from W. Line

C N L NW SE

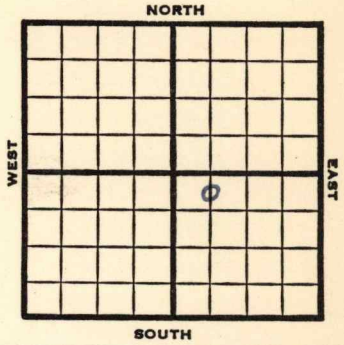

1953 **Elev. -** REPORT

4/1 Spud 3-15-53
 8" @ 80
Layton 1939, KC 1960, B KC 2201, Miss 2722
 DST 2760-68, opn 1 hr., rec.
 7' mud
 TD 2773
 5" @ 2768'

5/6 Spud 3-15-53
 D & A
 TD 2773'
 8" @ 80'
Layton 1939, KC 1960, B KC 2201, Miss 2722
 DST 2760-68 open 1 hr, rec 7' mud
 TD 2773'
 5" @ 2768'
 CO to 2773' VSSO 1000 A wtr.
 D & A

ABANDONED

County **Butler** State **Kansas**

Sec. **30** (Blk. **29**) (Sur. Rge.) **8E** Map No.

Operator **C. C. Nye**

Well No. **1** Farm **Wehrman**

Elev. Location **C N L NW SE**

330 Ft. From **N** Line **SE**

660 Ft. From **W** Line **Quarter**

1st. Report **APR 1 1953**

Completion

Remarks

Mendenhall - Contr.

Spudding Date **3-15-53**

FIRST REPORT

Drig. Data

8" @ 80 Layton 1939 KC 1960

B KC 2201 Miss. 2722 DST 2760-68

open 1 hr. Rec. 7' mud TD 2773 5" @ 27

2768

