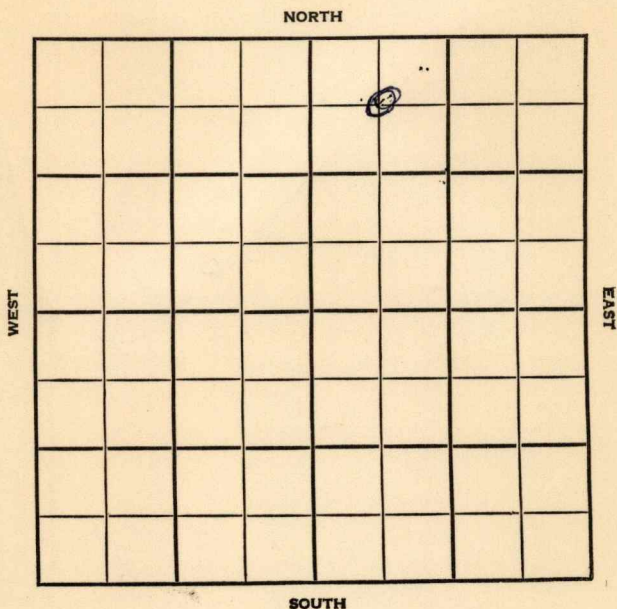


Section 21 Township 30 Range 1EWell No. #11 Rock Unit 2Company C R A

CORRECTION

FORM 513 SUNRAY

Co.

County Cowley Elev. 1162 DF
 Sec. 21 Twp. 30 Rge. 4E
 Company C R A
 Farm Name Rock Unit 2 No. 11

TOPS	DEPTH	LOG	DATUM	Loc. in Sec.
Anb.				<u>SW NE NW NE</u>
Tr.				<u>CNW NE</u>
H.				
Tr.				
Dg.				
Bl.				
L.				Geol.
K.C.	<u>2220</u>			Contr.
B.K.C.				<u>Prairie Tool</u>
Ce.	<u>2762</u>			Pool
C.				Rock
M.				
K.				
Mz.				
Mq.				
V.				
S.				
S.				
A.				
R.				
Pe.				
G.				
TD.	<u>2802</u>			

Loc.

No.

Sec.

T.

R.

Date Comm. spd. 11-19-56

rng. surf csg, then SD til FRI. NOV 28 '56

8578162/150 CR 9 @ 2764 DEC 5 '56

-72 Full rec

DEA

DEC 5 '56
 ABANDONED

County Cowley Elev. _____
 Sec. 21 Twp. 30 Rge. 4E
 Company C R A
 Farm Name Rock Unit 2 No. 11

TOPS	DEPTH	LOG	DATUM	Loc. in Sec.
Anh.				SW NE NW NE
TP.				
H.				
Tr.				
Dg.				
BL.				
L.				Geol.
K.C.				Contr.
B.K.C.				Prairie Tools
Ce.				Pool
C.				Rock
M.				
M.				
K.				
Mz.				
Me.				
V.				
S.				
S.				
A.				
R.				
PE.				
G.				
T.D.				

	0

FIRST REPORT
 NOV 21 1956

Date Comm. spd. 11-19-56

rng. surf csg, then SD til FRI.

29