



Sec. 10 Twp. 17 R. 12-W

Well No. #1 Wondra Farm  
C. L. Price et al Company


330 Ft. from N. Line

\_\_\_\_\_ Ft. from S. Line

\_\_\_\_\_ Ft. from E. Line

330 Ft. from W. Line

Elev. 1863

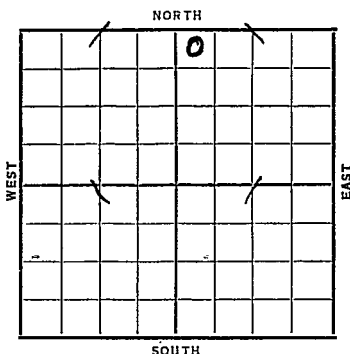

Date	REPORT
1938	
2/2	Cellar.
2/11	RUCT.
2/18	"
2/26	C. R.
3/4	R. U.
3/11	15" @ 72', 12" @ 265',
	Drl g. 330'.
3/18	Anhy 740', 12" @ 751',
	Drl g. 1260'.
3/25	Drl g. 1725'.
4/1	10" @ 1865', 8" @ 2435',
	T.D. 2485', U. R. 8".
4/8	8" @ 2503', Topeka 2708',
	Drl g. 3050'.
4/15	K.C. 3061', 1 B.W. 3095-3100',
	S.O. 3225-30', 6" @ 3295',
	Cong. 3320', Arb. 3333',
	T.D. 3335', S.O.
	<b>OVER</b>

1938

- 4/22 Pay 3341-43' T.D.  
6" @ 3334'. 1800' oil & 200'  
water in 12 hrs.  
P.B. 3342'. Testing.
- 4/29 Pump 85 fluid in 16 hrs.  
8% water. Will treat.
- 5/6 " " " "
- 5/12 2000 acid. Est. 190 oil per  
day. with show water.
- 5/20 Testing.

- 5/25 6" @ 3334'.  
Arb. 3333'.  
T.D. 3343'.  
P.B. 3342'.  
2000 acid.  
Potential 537 bbls.  
Plus 20% water.

COMPLETED

Barton

KANSAS

Map No. \_\_\_\_\_ Sec. 10 Twp. 17 R. 12WWell No. 1 WondraC. L. Price etal Company~~FIRST REPORT~~ Contractor

NW NE


330 Ft. from N. Line

\_\_\_\_\_ Ft. from S. Line

\_\_\_\_\_ Ft. from E. Line

330 Ft. from W. Line

## SECTION PLAT

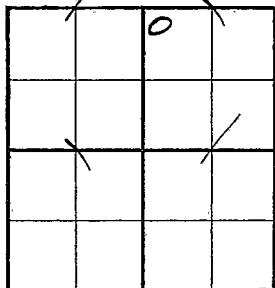

Location \_\_\_\_\_

Rig up \_\_\_\_\_

Drilling and Remarks:  
**Cellar**

## RECORD

Cased \_\_\_\_\_ in., \_\_\_\_\_ ft.

Sand \_\_\_\_\_

Gas \_\_\_\_\_

Oil \_\_\_\_\_

Total Depth \_\_\_\_\_

## PRODUCTION

1st 24 hrs. Nat. \_\_\_\_\_

1st 24 hrs. after shot \_\_\_\_\_

Gas \_\_\_\_\_ Cu. Ft.

Dry Hole \_\_\_\_\_

Abandoned \_\_\_\_\_

Date

FEB 2 1938 19 \_\_\_\_\_ H. D. Hatfield Scout

Barton **KANSAS**

Map No. 55 Sec. 10 Twp. 17 R. 12W

Well No. 1 Wondra

C. L. Price etal Company

Contractor

**COMPLETED**

NW NE

330 Ft. from N. Line

\_\_\_\_\_ Ft. from S. Line

\_\_\_\_\_ Ft. from E. Line

330 Ft. from W. Line

**SECTION PLAT**

		0	

Location \_\_\_\_\_

Rig up \_\_\_\_\_

Drilling and Remarks:

*P.B. 3342  
2000 acid  
Pot 537  
Plus 20 gal w/*

**RECORD**

Cased 6 in., 3334 ft.

Sand Arb 3333

Gas \_\_\_\_\_

Oil \_\_\_\_\_

Total Depth 3343

**PRODUCTION**

1st 24 hrs. Nat. \_\_\_\_\_

1st 24 hrs. after shot \_\_\_\_\_

Gas \_\_\_\_\_ Cu. Ft.

Dry Hole \_\_\_\_\_

Abandoned \_\_\_\_\_

Date

MAY 25 1938

19

H. D. Hatfield Scout