

KANSAS

Barton

FORM 51 5M 10-41 PETROL

Section 12 Township 17 Range 12-W

Well No. #1 Boor

Company Bartlett & Crum

NORTH

Oden Pool

14

WEST

EAST

0

SOUTH

KANSAS

Barton

Sec. 12 Twp. 17 R. 12-W

Well No. #1 Boor Farm

Bartlett & Crum Company

(Oden)

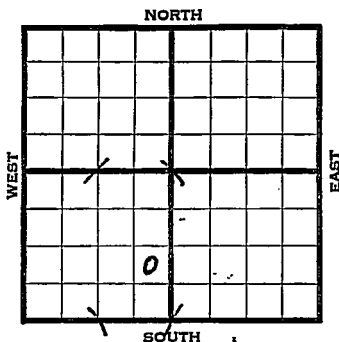
 Ft. from N. Line

990 Ft. from S. Line

330 Ft. from E. Line

 Ft. from W. Line

Elev. 1856



1942

REPORT

4/1 Rotary.

4/8 10" - 180' Drlg. 250'

4/15 Topeka 2610' Drlg. 2875'

4/22 Arb. 3423'

T.D. 3453'

No shows.

ABANDONED

Barton

KANSAS

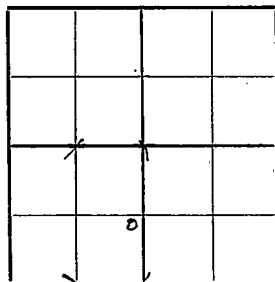
Map No. 55 Sec. 12 Twp. 17 R. 12WWell No. 1 BoorBartlett & Crum

Company

FIRST REPORT

Contractor

NE SE SW

SECTION PLAT Ft. from N. Line990 Ft. from S. Line330 Ft. from E. Line Ft. from W. Line**ODEN POOL**Location Rig up

Drilling and Remarks:

Rotary

RECORDCased in., ft.Sand Gas Oil Total Depth **PRODUCTION**1st 24 hrs. Nat. 1st 24 hrs. after shot Gas Cu. Ft.Dry Hole Abandoned

Date

APR 1 1942 19S. J. LEWIS

Scout

Map No. 5-5 Sec. 12 Twp. 17 R. 12WWell No. 1 BoorBartlett & Crum

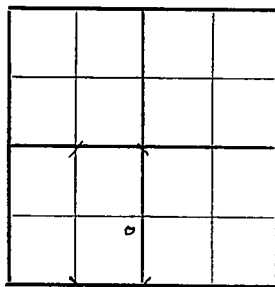
Company

ABANDONED

Contractor

NE SE SW

SECTION PLAT

 Ft. from N. Line990 Ft. from S. Line330 Ft. from E. Line Ft. from W. Line

ODEN POOL

Location Rig up

Drilling and Remarks:

Ch & 3423No shows

RECORD

Cased in., ft.Sand Gas Oil Total Depth 3453

PRODUCTION

1st 24 hrs. Nat. 1st 24 hrs. after shot Gas Cu. Ft.Dry Hole Abandoned

Date

APR 22 1942

19

S. J. LEWIS

Scout