

DX 78-1


Butler

KANSAS

Section 30 Township 29 Range 8E

Well No. #1 Ellis

Company Augusta Oil

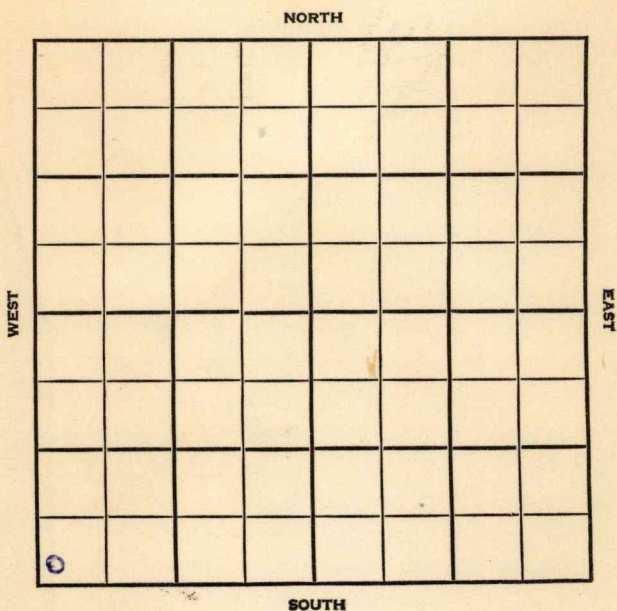

Butler

KANSAS

SEC.	TWP.	R.
30	29	8E

WELL NO.

1 Ellis

FARM

COMPANY

Augusta Oil

CONTRACTOR

Co. Tools

Wildcat


_____ Ft. from N. Line

_____ Ft. from S. Line

_____ Ft. from E. Line

_____ Ft. from W. Line

SW SW SW Lot 11

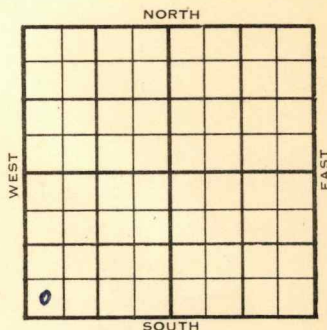

1955

ELEVATION

REPORT

6/15

Comm 6-9-55

8" @ 71/50

Layton 1710, KC 2050

Drlg 2148

6/22

Layton 1710, KC 2050, M 2802,

TD 2855

8" @ 71/50

D & A

ABANDONED

County Butler Elev. _____
 Sec. 30 Twp. 29 Rge. 8E
 Company Augusta Oil
 Farm Name Ellis No. 1

TOPS	DEPTH	LOG	DATUM	Loc. in Sec.
Anh.				SW SW SW
Tp.				Lot 11
H.				
Tr.				
Dg.				
Bl.				
L. ayton	1710			Geol. _____
K.C.	2050			Contr. _____
B.K.C.				
Ce.				Co. tools
C.				Pool _____
M.				Wildcat
M.				
K.				
Mz.				
Mq.				
V.				
S.				
S.				
A.				
R.				
Pe.				
G.				
T.D.				

FIRST REPORT

JUN 15 '55

Date Comm. 6-9-55
8" @ 71/50 drlg. 2148

County	Butler		Elev.		Co.	
Sec.	30	Twp.	29	Rge.		8E
Company	Augusta Oil					
Farm Name	Ellis		No.	1		

TOPS	DEPTH	LOG	DATUM	Loc. in Sec.	Lse.
Anh.				SW SW SW	
Tr.				Lot 11	
H.					
Tr.					
Dg.					
Bl.					
L. <i>ayton</i>	1710			Geol.	
K.C.	2050			Contr.	
B.K.C.				Co. tools	
Ce.				Pool	
C.				Wildcat	
M.	2802			ABANDONED	
M.					
K.					
Mz.					
Me.					
V.					
S.					
S.					
A.					
R.					
Pe.					
G.					
T.D.	2855			0	

Date Comm. 8" @ 71/50

D & A

JUN 22 1955

No. Sec. T. R.