

KANSAS

Barton


Form 51-5M-7-39-Palace

k

Section 15 Township 17 Range 12-W

Well No. #1 F. Wondra

Company ~~Howard Brunson~~ Phillips Petr.

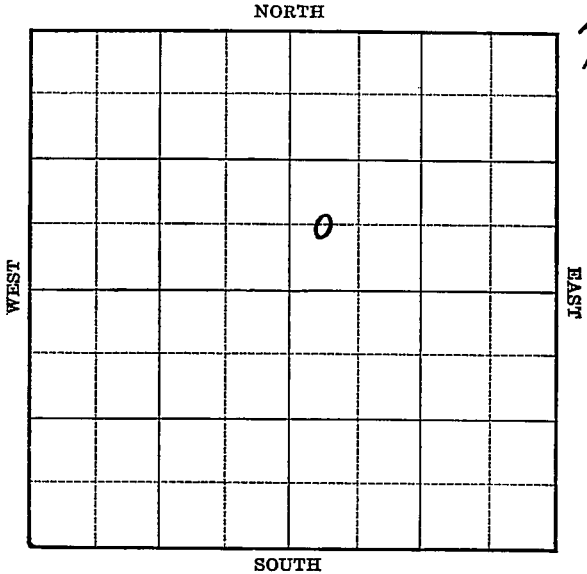

Sec. 15 Twp. 17 R. 12-W

Well No. #1 F. Wondra Farm

~~Howard Brunson~~ Phillips Petr Company


(Wildcat)

_____ Ft. from N. Line

660 Ft. from S. Line

_____ Ft. from E. Line

330 Ft. from W. Line

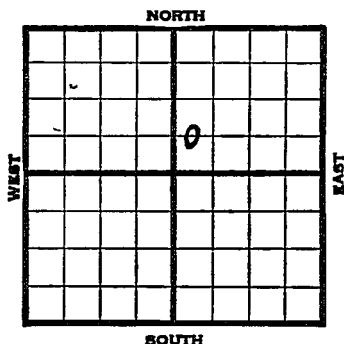

Elv. 1839

REPORT

1939	
12/6	Cable rig.
12/14	Spud 75'
12/21	15" - 380' Anhy 693'
	10" - 697' Drlg. 830'
12/28	Ft. Riley 1655' Drlg. 1840'
1940	
1/4	No report.
1/11	Topeka 2652' Drlg. 2680'
1/18	Drlg. 2882'
1/25	8" - 2412' Lans. 3049'
	S.O. 3060-70' 6" - 3060'
	S.O. 3120-25' 800' oil.
	1 B.W. 3125-30' T.D. 3140'
	U.R. 6".
2/1	Cong. 3292' 7" - 3286'
	Cherty Cong. 3306' Arb. 3316'
	SSO 3316-18' SO & W. 3318-20' TD
	8 bailers oil 4 hours. Shut down
2/8	TD 3325' water. P.B.
2/15	P.B. to 3054' 7" - 3054' C.O.
2/23	" " " " "

OVER

1940

2/29 T.D. 3090' 450' oil:
Shut down.

3/8 " "

3/14 500 acid. Pump 46 bbls. 4 hours

3/21 1000 acid. Pump 34 bbls. in 8
hours.

3/27 Arb. 3316' Lans. 3049'

7" - 3054'

T.D. 3325'

P.B. to 3090'

1500 acid.

Potential 101 bbls., pump.

COMPLETED

Barton

KANSAS

Map No. 55 Sec. 15 Twp. 17 R. 12W

Well No. 1 F. Wondra

Howard Brunson

Company

Contractor

FIRST REPORT

C W L SW NE

_____ Ft. from N. Line

660 Ft. from S. Line

_____ Ft. from E. Line

330 Ft. from W. Line

WILDGAT

SECTION PLAT

		0	

Location _____

Rig up _____

Drilling and Remarks:

. Cable

RECORD

Cased _____ in., _____ ft.

Sand _____

Gas _____

Oil _____

Total Depth _____

PRODUCTION

1st 24 hrs. Nat. _____

1st 24 hrs. after shot _____

Gas _____ Cu. Ft.

Dry Hole _____

Abandoned _____

Date

DEC 6 1939

19

S. J. LEWIS

Scout

Map No. 55 Sec. 15 Twp. 17 R. 12W

Well No. 1 F. Wondra

Phillips Petroleum Company

CORRECTION Contractor

C W L SW NE

SECTION PLAT

_____ Ft. from N. Line

660 Ft. from S. Line

_____ Ft. from E. Line

330 Ft. from W. Line

		o	

WILDCAT

Location _____

RECORD

Rig up _____

Cased _____ in., _____ ft.

Drilling and Remarks:

Sand _____

Reported

Gas _____

Howard Brunson.

Oil _____

**Phillips bought
this test.**

Total Depth _____

PRODUCTION

1st 24 hrs. Nat. _____

1st 24 hrs. after shot _____

Gas _____ Cu. Ft.

Dry Hole _____

Abandoned _____

Date

FEB 7 1940 19

S. J. LEWIS

Scout

Map No. 55 Sec. 15 Twp. 17 R. 12W

Well No. 1 F. Wondra

Phillips Petroleum Company

Contractor

COMPLETED

C W L SW NE

SECTION PLAT

_____ Ft. from N. Line

660 Ft. from S. Line

_____ Ft. from E. Line

330 Ft. from W. Line

		o	

WILDCAT

Location _____

RECORD

Rig up _____

Cased _____ in., _____ ft.

Drilling and Remarks:

Sand _____

at 3316 Lane 3047

Gas _____

7" @ 3054

Oil _____

P.B 3090

Total Depth 3225

1500 acid

Pump 101 P.O.

PRODUCTION

1st 24 hrs. Nat. _____

1st 24 hrs. after shot _____

Gas _____ Cu. Ft.

Dry Hole _____

Abandoned _____

Date

MAR 27 1940 19

S. J. LEWIS Scout