


Russell

Form 51-5M-5-34-Palace

Map No. *KANSAS* Sec. *27* Twp. *12* R. *15W*

Well No. *1-Herman* Farm  
*Winkler-Koch* Company

NORTH

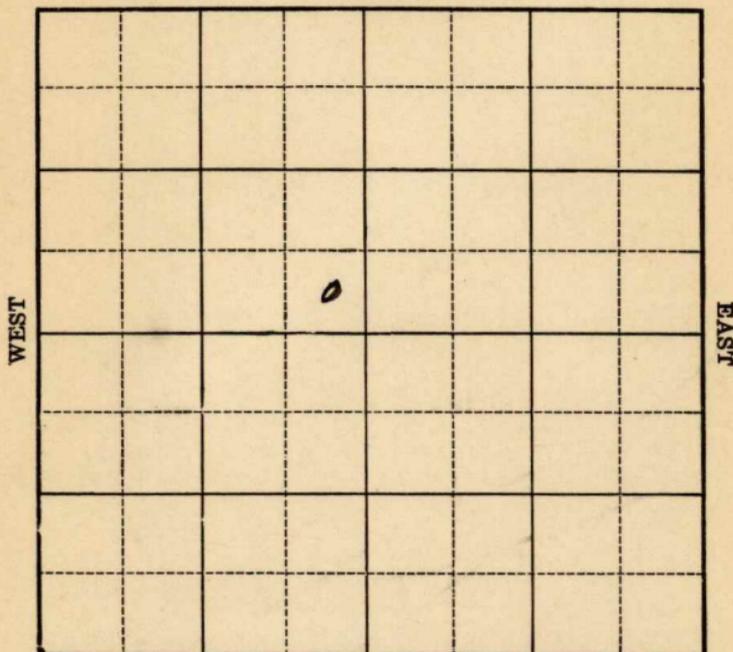

SOUTH

Location \_\_\_\_\_

Drilling Remarks \_\_\_\_\_

Rig Up \_\_\_\_\_

Drilling Remarks \_\_\_\_\_

RECORD

Cased \_\_\_\_\_ in. \_\_\_\_\_ ft.

Sand \_\_\_\_\_

Gas \_\_\_\_\_

Oil \_\_\_\_\_

Total Depth \_\_\_\_\_

PRODUCTION

1st 24 hrs. Nat. \_\_\_\_\_

1st 24 hrs. after shot \_\_\_\_\_

Gas \_\_\_\_\_ cu. ft.

Dry Hole \_\_\_\_\_


Abandoned \_\_\_\_\_

Russell

Map No. **KANSAS** Sec. **27** Twp. **12** R. **15<sup>w</sup>**

Well No. **1 - Herman** Farm  
**Winkler-Koch** Company

\_\_\_\_\_ Ft. from N. Line  
**330** Ft. from S. Line  
**330** Ft. from E. Line  
\_\_\_\_\_ Ft. from W. Line

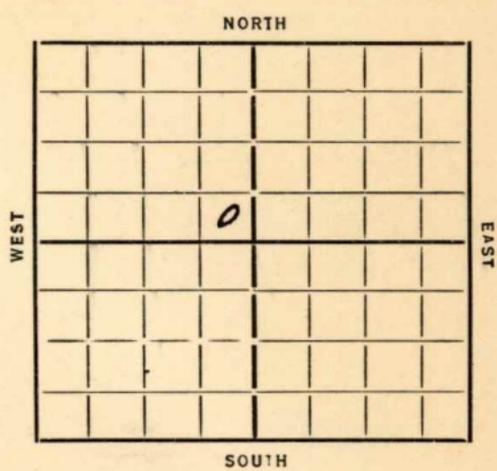

Date	REPORT
1935	
3/27	Location
4/4	Spud 0.57
4/11	— 4/18 — 4/26 — 5/2 — 5/9 —
5/16	—
5/23	450 sd
5/29	dly 600
6/6	" 1610 12" 575
6/13	" 2075 10" 923
6/20	sd 2507
6/28	Gas 2750-55
	T Topoka 2755- dly 2775
7/3	Overall 3030 U R 6"
7/11	dly 3230 6" 3120
7/17	sd 3338 T 3364
	J. A.

**ABANDONED**

Map No. 72 Sec. 27 Twp. 12 R. 15W

Well No. Herman

Winkler + Koch Company

Contractor

ABANDONED

SECTION PLAT


.....Ft. from N. Line

330 Ft. from S. Line

330 Ft. from E. Line

.....Ft. from W. Line

Location.....

Rig up.....

Drilling and Remarks:

10 + A

RECORD

Cased.....in.,.....ft.

Sand at 3338

Gas.....

Oil.....

Total Depth 3364

PRODUCTION

1st 24 hrs. Nat.....

1st 24 hrs. after shot.....

Gas.....Cu. Ft.

Dry Hole.....

Abandoned.....

Date

7-17-35 192.....

ORVAL MANNSCHECK

Scout

KANSAS

Map No. 77 Sec. 27 Twp. 12 R. 15W

Well No. 1-Herman

Winkler-Koch Company

Contractor

FIRST REPORT

SECTION PLAT

.....Ft. from N. Line

330 Ft. from S. Line

330 Ft. from E. Line

.....Ft. from W. Line


Location.....

Rig up.....

Drilling and Remarks:

RECORD

Cased..... in., ..... ft.

Sand.....

Gas.....

Oil.....

Total Depth.....

PRODUCTION

1st 24 hrs. Nat.....

1st 24 hrs. after shot.....

Gas..... Cu. Ft.

Dry Hole.....

Abandoned.....

Date

3-27-35 192 C. Winkler-Koch Scout