
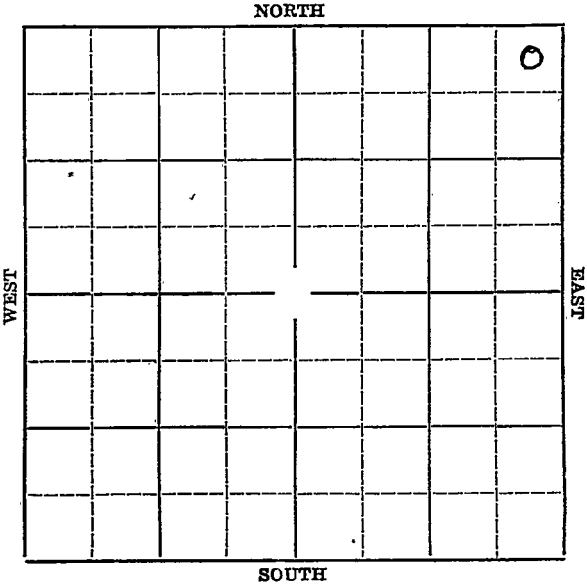


Section 17 Township 17 Range 12-W

Well Number 1 Beck

Company S. A. Murphy

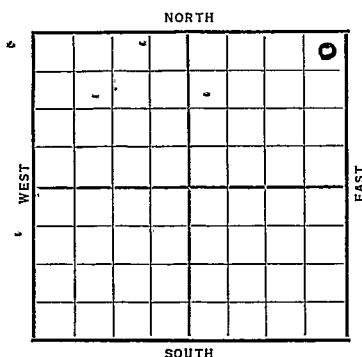

Sec. 17 Twp. 17 R. 12 WWell No. #1 Beck FarmS. A. Murphy Company330 Ft. from N. Line Ft. from S. Line330 Ft. from E. Line Ft. from W. Line

Date	REPORT
1937	
3/10	Location
3/18	" "
3/25	" "
4/2	" "
4/8	" "
4/16	" "
4/23	" "
4/30	" "
5/7	" "
5/14	" "
5/21	Rig
5/28	" "
6/4	" "
6/11	Spud & SD.
6/19	" "
6/25	" "
7/2	5" @ 330'. Drlg. 440'.
7/9	12" @ 481'. Anhy 760'.
	10" @ 770'. Drlg. 1480'.
7/16	8" @ 2125'. T.D. 2200'. U.K.
7/23	8" @ 2185'. Drlg. 2385'.
	OVER

1937

7/30 Drlg. 3890'.

8/6 S.W. 2960'. 6" @ 2960'. H.F.W. 2970-80
T.D. 3050'. U. R. 6".

8/13 6" @ 3070'. Osw. 3115'.
Cong. 3335'. T.D. 3368'.
Rng. 5".

8/18 5" @ 3405'.
Sil. 3391'.
T.D. 3419'.
H.F.W. 3413-19'.

ABANDONED

Map No. 55 Sec. 17 Twp. 17 R. 12WWell No. 1 Beck.S. A. Murphy Company

Contractor

SECTION PLAT

			0

330 Ft. from N. Line

_____ Ft. from S. Line

330 Ft. from E. Line

_____ Ft. from W. Line

FIRST REPORT

Location ✓

Rig up _____

Drilling and Remarks:

RECORD

Cased _____ in., _____ ft.

Sand _____

Gas _____

Oil _____

Total Depth _____

PRODUCTION

1st 24 hrs. Nat. _____

1st 24 hrs. after shot _____

Gas _____ Cu. Ft.

Dry Hole _____

Abandoned _____

Date

O

MAR 10 1937 19

S. J. LEWIS Scout

Barton **KANSAS**Map No. _____ Sec. 17 Twp. 17 R. 12Well No. 1-Beck*S. A. Murphy* Company
Contractor

ABANDONED

SECTION PLAT

			0

330 Ft. from N. Line

_____ Ft. from S. Line

330 Ft. from E. Line

_____ Ft. from W. Line

Location _____

Rig up _____

Drilling and Remarks:

*HFW 3413-19**D & A*

RECORD

Cased 5 in., 3405 ft.Sand 511 3391

Gas _____

Oil _____

Total Depth 3419

PRODUCTION

1st 24 hrs. Nat. _____

1st 24 hrs. after shot _____

Gas _____ Cu. Ft.

Dry-Hole _____

Abandoned _____

Date

AUG 18 1937 19 H. D. Hatfield Scout