


SECTION 29 TOWNSHIP 12 RANGE 15<sup>W</sup>

WELL NO. #1 Meckel

COMPANY Imperial Oil

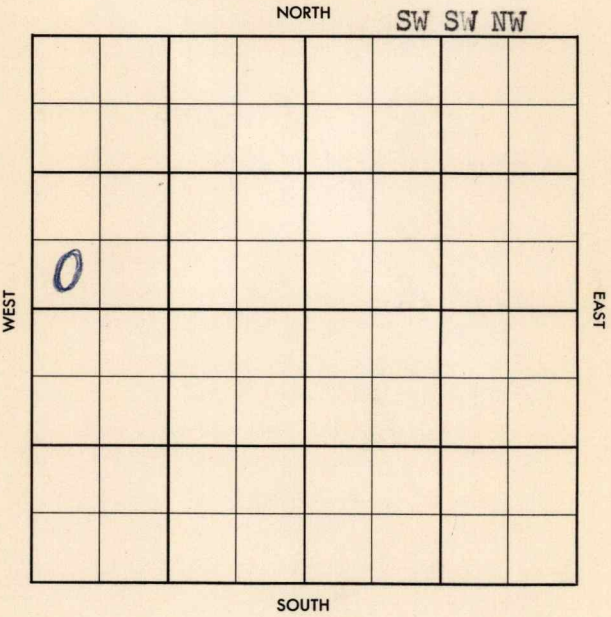

County Russell Elev. \_\_\_\_\_  
 Sec. 29 Twp. 12 Rge. 15W  
 Company Imperial Oil  
 Farm Name Meckel No. 1

TOPS	DEPTH	LOG	DATUM	Loc. in Sec. _____
Anb.				SW SW NW
Tp.				
H.				
Tr.				
Dg.				
Bl.				
L.				Geol. _____
K.C.				Contr. _____
B.K.C.				K & E Drlg.
Ce.				
C.				Pool _____
M.				
M.				
K.				
Mz.				
Mo.				
V.				
S.				
S.				
A.				
R.				
Pe.				
G.				
I.D.				

FIRST REPORT  
 JUL 31 57

Date Comm. 7-1-57  
 drlg. 452

*(Handwritten red mark)*

County Russell Elev. 1874  
 Sec. 29 Twp. 12 Rgs. 15W  
 Company Imperial Oil  
 Farm Name Meckel No. 1

TOPS	DEPTH	LOG	DATUM	Loc. in Sec.
Anh.	935			SW SW NW
TP.	2269			
H.	2986			
Tr.	3037			
Dg.				
BL.				
L.	3037			Geol.
K.C.				
B.K.C.	3276			Contr.
Ce.				K & N Dril.
C.	3315			
M.				Pool
M.				
K.				
Mz.				
Ma.				
V.				
S.				
S.				
A.	3349			
R.				
PE.				
G.				
T.D.	3391			

ABANDONED

JUL 17 1957

Date Comm. 7-1-57

drile. 452 JUL 10 1957 PT# 940/475

DST 2765-82 30" rec 3' Md

BHP 165 DST 2913-60 30"

rec 15' Md BHP 720 DST

3039-60 1hr rec 10' 50CM BHP

25 DST 3082-3102 30" rec

7' Md BHP 0 # 3110 JUL 17 1957

DST 3292-3320 of 1hr rec

10' Md BHP 55 D & A