
FORM 51 25M 8-50 WESTERN Barton KANSAS

Section 20 Township 17 Range 12 W

Well No. # 1 Rziha

Company Lindas Oil

9

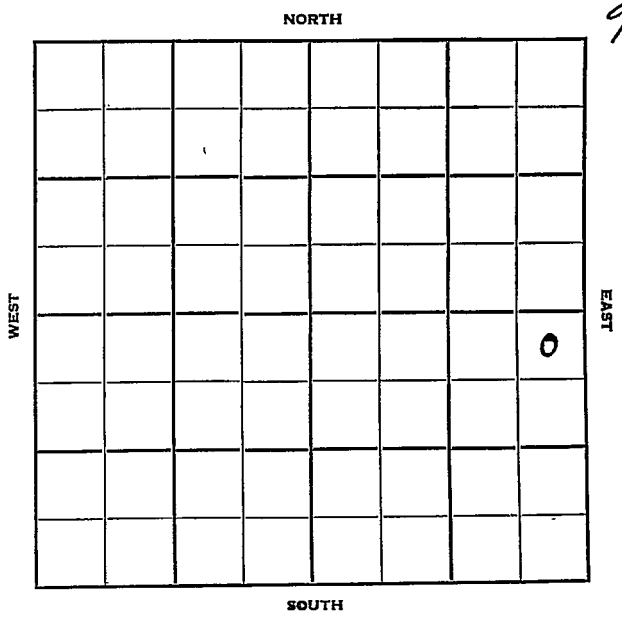

FORM 252-B
10M 8-51 TPCO.

Barton

KANSAS

Sec. 20 Twp. 17 R. 12W

Well No. #1 Rziha Farm

Lindas Oil Company

Lindas - Contr. Contractor

Wildcat


330' Ft. from N. Line

Ft. from S. Line

330' Ft. from E. Line

Ft. from W. Line

NE NE SE

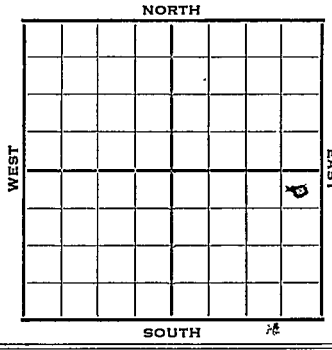

1952	1934 RB 1931 LS REPORT
6/4	8" @202 Heeb. 3080 Br Lime 3180 Lans. 3196 Drlg. 3230
6/11	Arb. 3435' 3452' RTD 5" @ 3447 DP 3457' Hole full OCM PB 3440'
6/18	S 1½ BO & 4 BWPH for 10 hrs. PB
6/25	D&A TD 3457 8" @ 202 Heeb. 3080 Br Li 3180 Lans. 3196 Arb. 3435 DST 3447-52 open 1½ hr. rec. 175' o & ~~g~~ m 5" @ 3447 TD 3457 FU 350' hocm B/ hocm 4 hr. S/ 1½ bo 4 bwph 17/ 3448-51 wtr. S/ 2 bo 10 bwpd D&A

ABANDONED

FORM 275 FOR SALE BY KANSAS BLUE PRINT CO.


County Barton State Kansas

Sec. 20 (Blk. Twp.) 17 (Sur. Rge.) 12W Map No.

Operator Lindas Oil

Well No. 1 Farm Rziha

Elev. 1934 RB 1931 LS Location NE NE SE

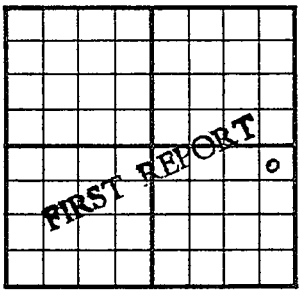

330 Ft. From N Line SE

330 Ft. From E Line Quarter

1st. Report JUN 4 1952

Completion

Remarks

Lindas - Contr.

Spudding Date

Drlg. Data Wildcat

8" @ 202 Heeb. 3080 Br. lime 3180

Lans. 3196 drlg. 3230

J. G. McGEHEE

FORM 275 FOR SALE BY KANSAS BLUE PRINT CO


County Barton State Kansas

Sec. 20 (Blk. Twp.) 17 (Sur. Rge.) 12W Map No.

Operator Lindas Oil

Well No. 1 Farm Rziha

Elev. 1931 Location NE NE SE

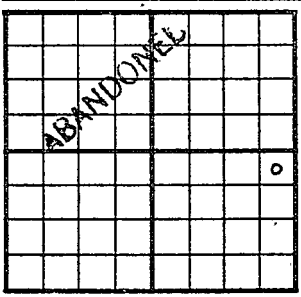

330 Ft. From N Line SE

330 Ft. From E Line Quarter

Ist. Report

Completion JUN 25 1952

Remarks Wildcat

Lindas - Contr.

Spudding Date

Drlg. Data D & A TD 3457

8" @ 202 Heeb. 3080 Br. lime 3180

Lans. 3196 Arb. 3435 DST 3447-52

open 1½ hr. Rec. 175' o & m 5" @ 3447

TD 3457 FU 350' hocm B/ hocm 4 hr.

S/ 1½ bo 4 bwph 17/ 3448-51 water

S/ 2 bo 10 bwpd

D & A

J. G. McGEHEE