


Section 29 Township 12 Range 15W

Well No. #1 Meckel

Company L.C. Camblin (Tulsa)

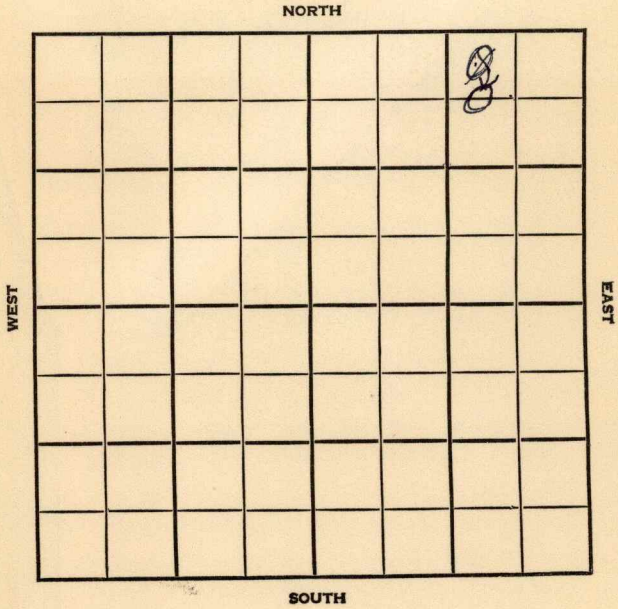

County Russell Elev. _____
 Sec. 29 Twp. 12 Rge. 15W
 Company L. C. Camblin (Tulsa)
 Farm Name Meckel No. 1

TOPS	DEPTH	LOG	DATUM	Loc. in Sec.
Anh.				NW NE NE
T.P.				
H.				
Tr.				
Dg.				
B.L.				
L.				Geol. _____
K.C.				Contr. _____
B.K.C.				
Ce.				Welch & Olsson
C.				
M.				Pool _____
M.				Fairport
K.				
Mz.				
Ma.				
V.				
S.				
S.				
A				
R.				
PE.				
G.				
T.D.				



Date Comm. RUR

Co.
No.
Sec.
T.
R.

CORRECTION

FORM 513 SUNRAY

County Russell Elev. 1866
 Sec. 29 Twp. 12 Rge. 15W
 Company L. O. Camblin (Tulsa)
 Farm Name Neckel No. 1

TOPS	DEPTH	LOG	DATUM	Loc. in Sec.
Anh.				NW NE NE W2
TP.	2756			
H.	2776			
Tr.	2998			
Dg.				
BL.				
L.	3023			
K.C.				Geol. _____
B.K.C.				Contr. _____
Ce.				
C. <u>cherty</u>	3298			Welch & Olsson
M.				
M.				Pool
K.				Fairport
Mz.				
Me.				
V.				
S.				
S.				
A.	3314?			ABANDONED
R.				
PE.				
G.				DEC 13 '56
T.D.	3350			

Date Comm. RUP NOV 28 '56 11-22-56 P 578
230 Tite DEC 5 '56
DST 2926-45 1hr 45' WM
BHP 900 / 30' DEC 12 '56

D & O (Held)