

Section 20 Township 17 Range 12WWell No. #1 ReimanCompany M. B. Armer, Crowe Drlg. & Alladin

NORTH

14

SOUTH

EAST

WEST

D

Barton

KANSAS
12W

Sec. 20 Twp. 17 R. 12W

Well No. #1 Reiman Farm

M.B. Armer, Crowe Drlg. & Alladin Company

Contractor

Wildcat


 Ft. from N. Line

330' Ft. from S. Line

330' Ft. from E. Line

 Ft. from W. Line

SE SE SW

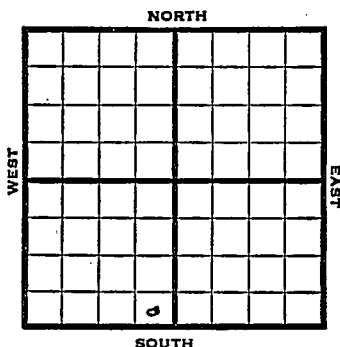

1950

Elev. 1895' REPORT

12/20


Spud 12-15-50
8" @ 192'

1951
1/10

Spud 12-15-50
D&A TL 3465
8" @ 192' Top. 2742
Br Lime 3163 Lans. 3178
Cong. 3430 Arb. 3434
TD 3465 D&A

ABANDONED

County Parson State Kansas
 Sec. 20 (Blk.) 17 (Sur.) 12W Map No.
 Operator M. B. Armer, Crowe Drlg. & Alladin
 Well No. 1 Farm Reiman
 Elev. Location SE SE SW

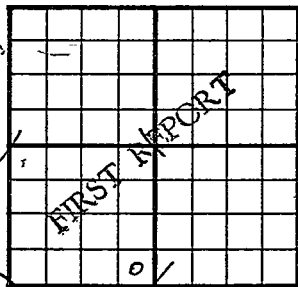


330 Ft. From S Line SW
330 Ft. From E Line Quarter
 1st. Report DEC 20 1950
 Completion
 Remarks Amerada, Skelly &
Champlin DHM
 Spudding Date 12-15-50

Drlg. Data Wildcat

8" @ 192

County Barton State Kansas
 Sec. 20 (Blk.) 17 (Sur.) 12W Map No.
 Operator M.B. Armer, Crowe Drlg. & Alladin
 Well No. 1 Farm Reiman
 Elev. 1895 Location SE SE SW

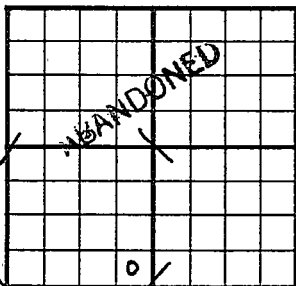

330 Ft. From S Line SW
330 Ft. From E Line Quarter

1st. Report

Completion JAN 1 0 1951

Remarks Wildcat

Spudding Date 12-15-50

Drlg. Data D & A TD 3465

8" @ 192 Top. 2742 Br. lime 3163

Lans. 3178 Cong. 3430 Arb. 3434

TD 3465 D & A

J. E. TYRA