
FORM 51 25M 3-49 PETROL

Russell KANSAS

Section 26 Township 12 Range 15W

Well No. #1 Ross

Company Anschutz Drlg.

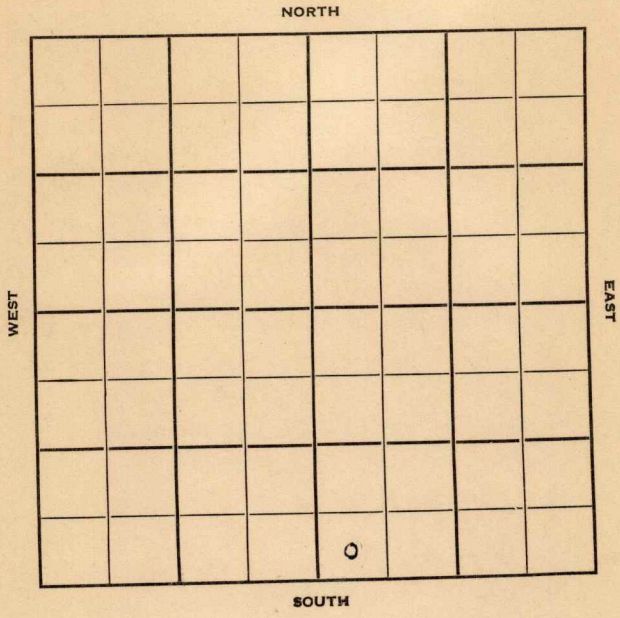

FORM 252-A
5M 10-48 PETROL

Russell KANSAS

Sec. 26 Twp. 12 R. 15W

Well No. #1 Ross Farm

Anschutz Drlg. Company

Wildcat (Anschutz Drlg, Contr.)


_____ Ft. from N. Line

330' Ft. from S. Line

_____ Ft. from E. Line

330' Ft. from W. Line

SW SE

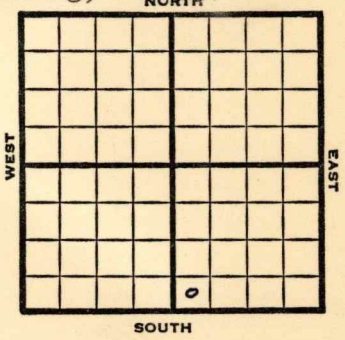

1949	Elev. 1789' REPORT
12/21	8" @ 134'
	Drlg. 2025'
12/28	Lans. 2984'8
	Arb. 3264'
	TD 3314'
	ABANDONED

Form 26 200 Bks. 6-49 Petrol

Kansas

Wildcat

Map No. _____ Sec. 26 Twp. 12 R. 15W

Well No. 1 Ross


Anschutz Drlg. Company

Anschutz Drlg. Contractor

SW SE

FIRST REPORT

SECTION PLAT

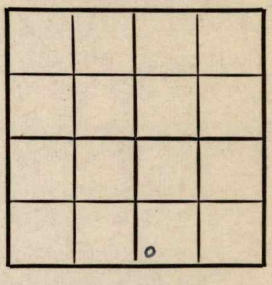

_____ Ft. from N. Line

330 Ft. from S. Line

_____ Ft. from E. Line

330 Ft. from W. Line

Russell County

Location _____

Rig up _____

Drilling and Remarks:

8" @ 134

drlg. 2025

RECORD

Cased _____ in., _____ ft.

Sand _____

Gas _____

Oil _____

Total Depth _____

PRODUCTION

1st 24 hrs. Nat. _____

1st 24 hrs. after shot _____

Gas _____ Cu. Ft.

Dry Hole _____

Abandoned _____

Date

DEC 21 1949 19 _____

S. J. LEWIS Scout

Form 26 200 Bks. 6-49 Petrol

Kansas Wildcat

Map No. ____ Sec. 26 Twp. 12 R. 15W


Well No. 1 Ross

Anschutz Drlg. Company

ABANDONED Contractor

SW SE E. 1178'

SECTION PLAT

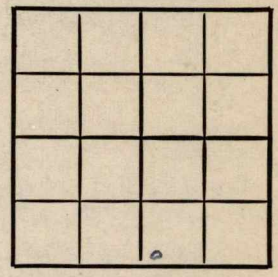

____ Ft. from N. Line

330 Ft. from S. Line

____ Ft. from E. Line

330 Ft. from W. Line

Russell County

Location ____

Rig up ____

Drilling and Remarks:

Lans 2984

Arb 3264

RECORD

Cased ____ in., ____ ft.

Sand ____

Gas ____

Oil ____

Total Depth 3314

PRODUCTION

1st 24 hrs. Nat. ____

1st 24 hrs. after shot ____

Gas ____ Cu. Ft.

Dry Hole ____

Abandoned ____

Date

DEC 28 1949 19

S. J. LEWIS Scout