Cowley KANSAS

SECTION 10 TOWNSHIP 33S RANGE 3E

WELL NO. #3-Bradbury

COMPANY Crest Petr.

C N/2 SE SE

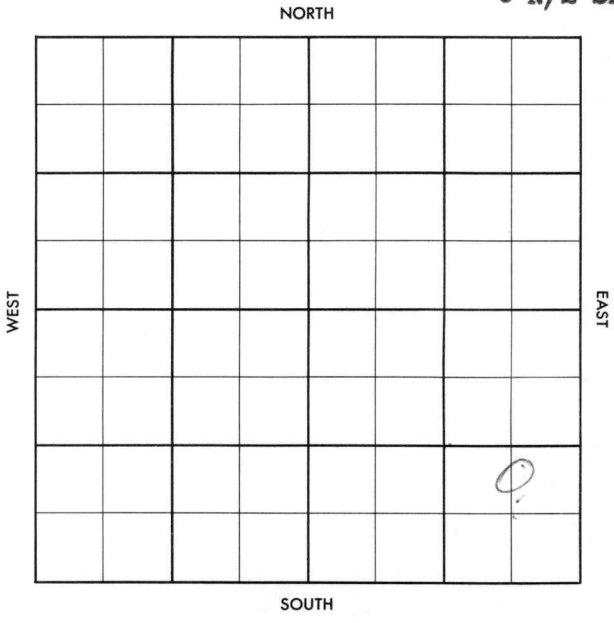

FORM 504-3 SUNRAY

FORM 513 SUNRAY

County Cowley Elev.

Sec. 10 Twp. 33 Rge. 3E

Company Crest Petroleum

Farm Name Bradbury No. 3

TOPS	DEPTH	LOG	DATUM
Anh.			
Tp.			
H.			
Tr.			
Dg.			
B.L.			
L.			
K.C.			
B.K.C.			
Ce.			
C.			
M.			
M.			
K.			
Mz.			
Mo.			
V.			
S.			
S.			
A			
R.			
P€.			
G.			
T.D.			

Loc. in Sec. C N½ SE SE

Geol.

Contr. Wrico

Pool Graham

FIRST REPORT

JUL 17 7

Date Comm.

Location

Co. Lse. No. Sec. T.

FORM 513 SUNRAY

County Cooley Elev. 1162

Sec. 10 Twp. 33 Rge. 3E

Company Crest Petroleum

Farm Name Bradbury No. 3

TOPS	DEPTH	LOG	DATUM
Anh.			
Tp.			
H. Staln	2208		
Tr.			
Dg. Lay	2616		
B.L.			
L.			
K.C.	2792		
B.K.C.			
Ce. Osw	2976		
C.			
M. ccsh	3090		
M. chert	3254		
K.			
Mz.			
Mo.			
V.			
S.			
S.			
A			
R.			
P€.			
G.			
T.D.	3264		

Loc. in Sec. C NE SE SE

Geol.

Contr. Wrico

Pool Graham

COMPLETE SEP 11 '57

Date Comm.

Location' JUL 24 57 MIR JUL 31 57

8 5/8 110 @ 3060

AUG 8 57 Tops RTD 3264 5½ @ 3256/150 MICT CO AUG 14 57 MICT CO 3264 no tst nat Frac 4x4 Flowed Ld & Flowed 107 BO no/w 24hrs WO tst. AUG 21 57 AUG 28 57 X WO POT SEP 4 57 SEP 11 57 PHF 285 BO + 270 W Open Ho