


Section 30 Township 12 Range 15 W

Well No. #1 Austin "C"

Company Stanolind O&G

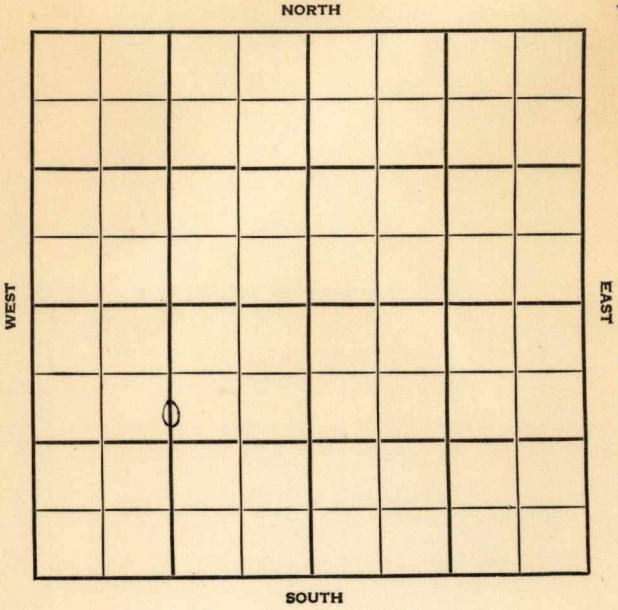

Russell

KANSAS

SEC. 30	TWP. 12	R. 15W
---------	---------	--------

WELL NO.

#1 Austin "C"

FARM

COMPANY

Stanolind O & G

CONTRACTOR

Barbour

Airport


\_\_\_\_\_ Ft. from N. Line

\_\_\_\_\_ Ft. from S. Line

\_\_\_\_\_ Ft. from E. Line

\_\_\_\_\_ Ft. from W. Line

C S $\frac{1}{2}$  N $\frac{1}{2}$  SW

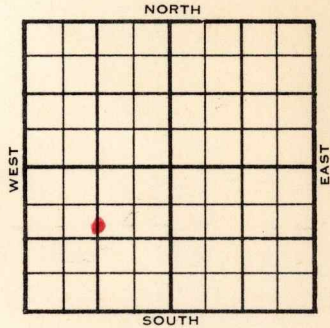

1955	ELEVATION	REPORT
8/3	MIR	<b>FIRST REPORT</b>
9-7	8 5/8" @ 960/475	DST 3001-20, open 1 hr., rec. 11' drlg. lud 20/20"
	DST 3044-95,	open 1/2 hr., rec. 210' gas 54' drlg. mud 245/20"
	DST 3160-3220,	open 1/2 hr., rec. 100' GIP 75' socm, 370#
	5 1/2" @ 3321/200,	CO to 3294 16/ 3272-76 4 gmcoph 8/ 3251-53 2000 A SP3241
	12/ 3197-3200 dry	24/ 3178-84
	S/ 2 goph 2000 A DP 3241 S/ 1.67 boph	CO to 3294, PB 3167 12/3085-88
	1 goph, 12/ 3070-73 1/2 goph 24/ 3044-	50 S/ 1 go 3 gwph 3500 A S/3 3/4
	bfp 90% wtr.	
	SP 3035 8/ 3008-10, S/ 5 bfp 60% wtr	1000 A S/ 1/2 bfp 90% wtr.
	CO to 3294 S/ 56 bo 63 bw 15 hr.	S/ 5 3/4 bfp 50% wtr.
	Comp. 54 bopd 60 BW	
	Tops: Anh. 950, H. 2988, 2988	Dodge 3004, 3007, L. 3042, 3040
	B.K.C. 3282	
	T.D. 3322	


COMPLETED



County Russell Elev. 1907  
 Sec. 30 Twp. 12 Rge. 15W  
 Company Stanolind O & G  
 Farm Name Austin "C" No. 1

TOPS	DEPTH	LOG	DATUM
Anh.	950	950	
Tr.			
H.	2988	2988	1081
Dg.	3004	3007	1100
Bl.			
L.	3042	3040	1133
K.C.			
B.K.C.		3282	1375
Ce.			
C.			
M.			
M.			
K.			
Mz.			
Me.			
V.			
S.			
S.			
A.			
R.			
PE.			
G.			
T.D.	3322		

Loc. in Sec. C S<sup>1</sup>/<sub>2</sub> N<sup>1</sup>/<sub>2</sub> SW  
 Geol. \_\_\_\_\_  
 Contr. \_\_\_\_\_  
 Barbour  
 Pool  
 Airport

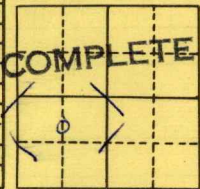

Date Comm. 8-1-55 SEP 7 1955

8 5/8" @ 960/475 DST 3001-20  
 open 1 hr. Rec. 11' drlg. lud 20/20"  
 DST 3014-95 open 1/2 hr. Rec. 210' gas  
 5 1/4' drlg. mud 245/20" DST 3060-3220  
 open 1/2 hr/ Rec. 100' GIP 75' socm  
 370# 5 1/2" @ 3321/200 CO to 3294  
 16/ 3272-76 4 gmcoph 8/ 33251-53  
 2000 A SP 3241 12/ 3197-3200 dry

OVER

24/ 3178-84 S/ 2 goph 2000 A  
 DP 3241 S/ 1.67 boph CO to 3294  
 PB 3167 12/ 3085-88 1 goph  
 12/ 3070-73  $\frac{1}{2}$  goph 24/ 3044-50  
 S/ 1 go 3 gwph 3500 A S/ 3  $\frac{3}{4}$  bfph  
 90% wtr. SP 3035 8/ 3008-10  
 S/ 5 bfph 60% wtr. 1000 A S/  $\frac{1}{2}$  bfph  
 90% wtr. CO to 3294 S/ .56 bo 63 bw  
 15 hr. S/ 5  $\frac{3}{4}$  bfph 50% wtr.  
 Comp. 54 bopd 60 bw

Scout Cards *PL*  
 Land Small Map  
 Land Wall Map  
 Tracings  
 France Map  
 Pierce Map  
 Misc

SEP 15 1955