KANSAS


Cowley

SECTION 10 TOWNSHIP 33 S RANGE 3 E

WELL NO. # 5 Bradbury

COMPANY Crest Petroleum

S/2 NE SE

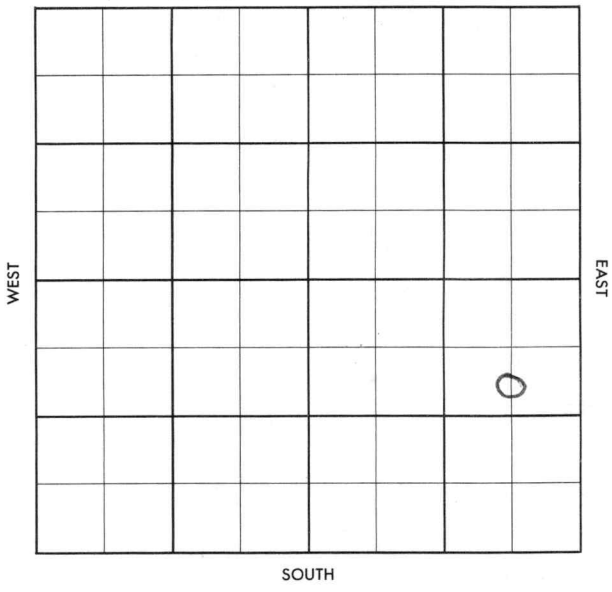

FORM 504-3 SUNRAY

FORM 513 SUNRAY

County Cowley Elev.

Sec. 10 Twp. 33S Rge. 3E

Company Crest Petroleum

Farm Name Bradbury No. 5

TOPS	DEPTH	LOG	DATUM
Anh.			
T.P.			
H.			
Tr.			
Dg.			
B.L.			
L.			
K.C.			
B.K.C.			
Ce.			
C.			
M.			
M.			
K.			
Mz.			
Mq.			
V.			
S.			
S.			
A			
R.			
P€.			
G.			
T.D.			

Loc. in Sec. S½ NE SE

Geol.

Contr. Wrico Tools

Pool Graham

AUG 21 '57

FIRST REPORT

Date Comm. 8-17-57

8 5/8" @ 110, Drlg. 300

29

Co. Lse. No. Sec. T. R.

FORM 513 SUNRAY

~~1162 DF~~
1162 DF
County Cowley Elev. 1165 KB

Sec. 10 Twp. 33S Rge. 3E

Company Crest Petroleum

Farm Name Bradbury No. 5

TOPS	DEPTH	LOG	DATUM
Anh.			
Tp. Staln	2192	X	
H.			
Tr. Lay	2606		
Dg.			
Bl.			
L.			
K.C.	2782		
B.K.C. OSW	2920		
Ce. cesh	3086		
C.			
M. chat	3242		
M.			
K.			
Mz.			
Mo.			
V.			
S.			
S.			
A			
R.			
P€.			
G.			
T.D.	3252		

Loc. in Sec. S½ NE SE

Geol.

Contr. Wrico Tools

Pool Graham

COMPLETE
OCT 16 '57

Date Comm. 8-17-57

8 5/8" @ 110, Drlg. 300 AUG 28 '57 EL

-Tops 5½ 3244 WOCT

Rig to 1st Report, SEP 4 '57 X

RUCT SEP 11 '57 CO frac F160 BOPH

+tr gwtr Flo 75 BOPH-no

watr. SEP 25 '57 OCT 2 '57 OCT 9 '57

OCT 16 '57 Flo 25 BOPD