


Ellis

KANSAS

SECTION 3 TOWNSHIP 13 RANGE 17W

WELL NO. #2 Schmidt "B"

COMPANY Earl Wakefield

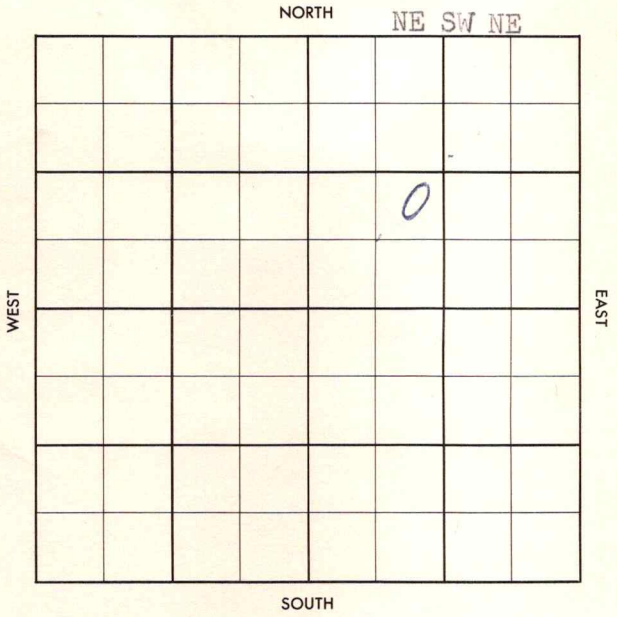

REPORT

FORM 513 SUNRAY

County Ellis Elev. _____
Sec. 3 Twp. 13 Rgs. 17W
Company Earl Wakefield
Farm Name Schmidt "B" No. 2

TOPS	DEPTH	LOG	DATUM	Loc. in Sec.
Anh.				NE SW NE
T.P.				
H.				
Tr.				
Dg.				
BL.				
L.				Geol. _____
K.C.				Contr. _____
B.K.C.				Co. tools
Ce.				
C.				Pool
M.				Catherine
M.				FIRST REPORT JUN 19 1957
K.				
Mz.				
Me.				
V.				
S.				
S.				
A.				
R.				
Pe.				
G.				
T.D.				

Date Comm.

M I R

~~14~~

Co.

Loc.

No.

Sec.

T.

R.

County Ellis Elev. 2055 RB
 Sec. 3 Twp. 13 Rge. 17W
 Company Earl Wakefield
 Farm Name Schmidt "B" No. 2

TOPS	DEPTH	LOG	DATUM	Loc. in Sec.
Anh.				NE SW NE
Tp.				
H.	X 3261			
Tr.	3281			
Dg.				
Bl.				
L.	3307	3307		Geol.
K.C.				Contr.
B.K.C.				Co. tools
Ce.				
C.				
M.				
M.				
K.				
Mz.				Pool
Mq.				Catherine
V.				
S.				
S.				
A.	3589			
R.				
Pe.				
G.				
TD.	3630			

	AUG 28 '57	
	0	
COMPLETE		

Date Comm.

M I R JAN 28 '57 6-18-57 85/8 161
1125 1125 3058 JUL 2 '57 1125 1125
DST 3321-37 1 hr 365' Gas in pipe
run 205' Foamy oil + 50' MW
FP 65-135 13HP 905' FBHP 855'
DST 3360-80 or 1 hr 510'
GIP run 146' OEGCM FP 30-55'
13HP 830' FBHP 650' FW 3589'
RTD 3630 5 1/2 3594' WOCT
Rig to Phillips Co. JUL 10 '57

MICT CO JUL 17 57 CO 3500

14/3401-08 6/3380-85

10/3332-37 6/3306-09

PKR @ 3350 Total $\uparrow$ to PF.

3401-08 & 3380-85 \$ 3

Boph nolwtr Polled PKR gave

150 G acid to PF. 3332-37

\$ 4 Boph nolw $\uparrow$ \$ 6 Boph
nolwtr PKR @ 3312 $\frac{1}{2}$ PF. 3306-09

\$ 4 Boph nolw pulled all PKRs

no overall \$ +st T&R JUL 24 57

w.o. pump. JUL 31 57 X w.o. Pump unit

AUG 8 57 AUG 14 57 AUG 21 57 AUG 28 57 Ph P. 151

Bopd + 1 nolwtr grav 35°

3.13.17W

ne sw ne