


Section.....30.....Township.....12.....Range 15-W.....

Well Number.....3 Deckert.....

Company.....Central Pet.....

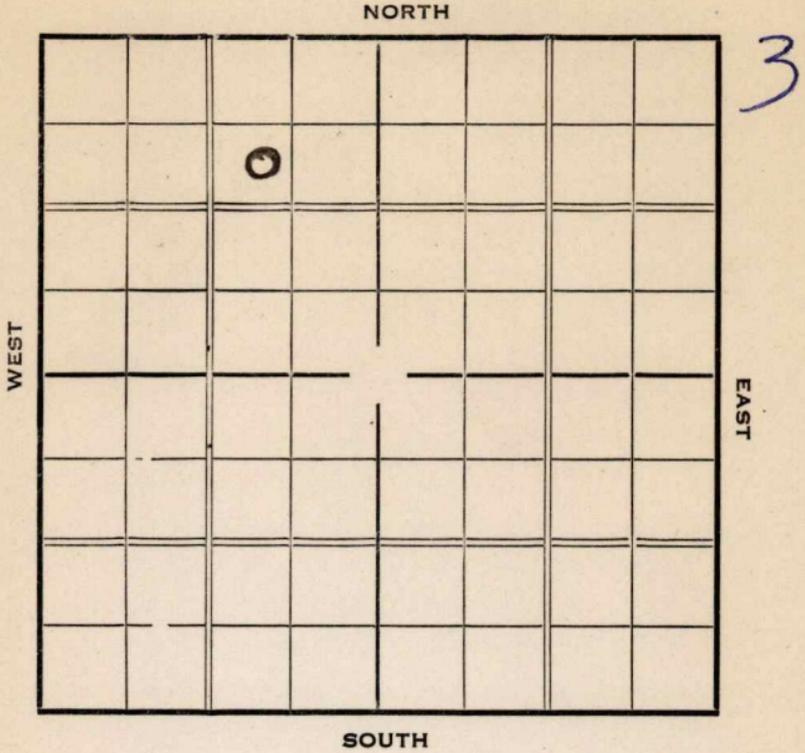

Sec. 30 Twp. 12 R. 15-W

Well No. #3 Deckert Farm

Central Pet. Company


990 Ft. from N. Line

_____ Ft. from S. Line

790 Ft. from E. Line

_____ Ft. from W. Line

Elev. 1902

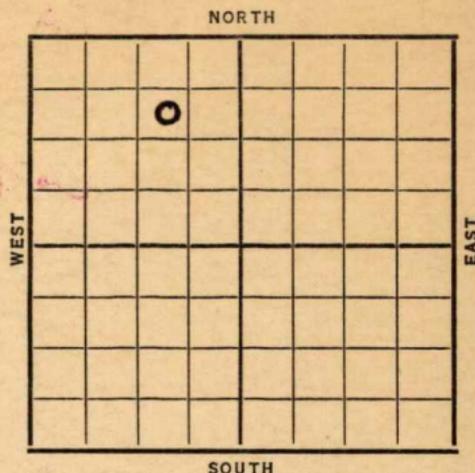

Date	REPORT
1937	
3/31	Rig
4/8	Rigging up
4/16	15" @ 385' Drlg. 550'
4/23	12" @ 638'. Anhydrate 943'.
	10" @ 955'. Drlg. 1780'.
4/30	" " " " "
5/7	8" @ 2730'. Show oil 2760'.
	K.C. 3032'. Rng. 6'
5/14	6" @ 3032'. T.D. 3085'.
	6000 acid.
5/19	6" @ 3032'.
	K.C. 3032'.
	T.D. 3085'.
	6000 acid.
	Pot. 504 bbls. 24 hrs.
	COMPLETED

KANSAS *Russell*

Map No. _____ Sec. 30 Twp. 12. R. 15W.

Well No. 3 Decker J

Central P. Y. Company

Contractor

SECTION PLAT

	0		

990 Ft. from N. Line

_____ Ft. from S. Line

790 Ft. from E. Line

_____ Ft. from W. Line

FIRST REPORT

Location _____

Rig up _____

Drilling and Remarks:

Rig

RECORD

Cased _____ in., _____ ft.

Sand _____

Gas _____

Oil Y _____

Total Depth _____

PRODUCTION

1st 24 hrs. Nat. _____

1st 24 hrs. after shot _____

Gas _____ Cu. Ft.

Dry Hole _____

Abandoned _____

Date

MAR 31 1937

Russell

KANSAS

Map No. 72 Sec. 30 Twp. 12 R. 15^w

Well No. 3-Deekard

Central Pet. Company

Contractor

COMPLETED

SECTION PLAT

990 Ft. from N. Line

_____ Ft. from S. Line

790 Ft. from E. Line

_____ Ft. from W. Line

	0		

Location _____

Rig up _____

Drilling and Remarks:

6000 Acid

Pot. - 504 / 24 hr

RECORD

Cased 6 in., 3032 ft.

Sand K.C., 3032

Gas _____

Oil _____

Total Depth 3085

PRODUCTION

1st 24 hrs. Nat. _____

1st 24 hrs. after shot _____

Gas _____ Cu. Ft.

Dry Hole _____

Abandoned _____

Date

MAY 19 1937

19

H. D. Hatfield

Scout