


SECTION 10 TOWNSHIP 33 RANGE 3E

WELL NO. #3 Nixon (Nixon)

COMPANY Frank Taylor

NORTH ^c
~~N/2 N/2~~ SE

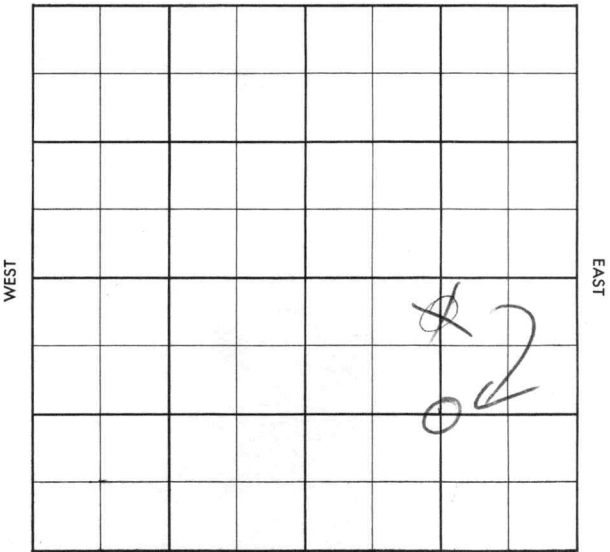

County Cowley Elev. _____
 Sec. 10 Twp. 33 Rge. 3E
 Company Frank Taylor
 Farm Name Nixson No. 3

TOPS	DEPTH	LOG	DATUM	Loc. in Sec.
Anh.				N/2 N/2 SE
Tr.				
H.				
Tr.				
Dg.				
Bl.				
L.				Geol. _____
K.C.				Contr. _____
B.K.C.				Crisswell Dr. Leg.
Ce.				
C.				Pool
M.				Centennial
M.				
K.				
Mz.				
Me.				
V.				
S.				
S.				
A.				
R.				
Pe.				
G.				
T.D.				

FIRST REPORT
 JUN 12 1957

Date Comm. _____
 Location _____

29

Co.
 Leg.
 No.
 Sec.
 T.
 R.

CORRECTION

FORM 519 SUNRAY

County Cowley Elev. 1162
 Sec. 10 Twp. 33 Rge. 3E
 Company Frank Taylor
 Farm Name Nixson No. 3

TOPS	DEPTH	LOG	DATUM
Anh.			
Tr.			
H.			
Tr.			
Dg.			
Bl. <u>Lay</u>	<u>2599</u>		
L.			
K.C.	<u>2769</u>		
B.K.C.			
Ce. <u>Marm</u>	<u>2955</u>		
C.			
M. <u>chert</u>	<u>3235</u>		
M.			
K.			
Mz.			
Mq.			
V.			
S.			
S.			
A.			
R.			
Pf.			
G.			
T.D.	<u>3246</u>		

Loc. in Sec. #2 SE
~~#2 SE~~
~~#2 SE~~
 Geol. _____
 Contr. _____
 Crisswell Dr. _____
 Pool _____
 Centennial _____

COMPLETE

SEP 4 '57

Date Comm. _____
 Location JUN 19 '57 878 200
1150 JUN 26 '57 MIRT III 3 '57
6-26-57 #2620 JUL 10 '57
DST 3236-46 1hr 90' Mdy oil
BHP 1000/20 5 1/2 3237 JUL 17 '57
C0 3246 Frac Flwg 6 Boph
JUL 24 '57 JUL 31 '57 wo pot AUG 8 '57 AUG 14 '57
wo pot. AUG 21 '57 AUG 28 '57 wo pot.
X Flwg 12 Boph 8 1/4" choke wo pot.

10-33-3E

FORM 513-1 SUNRAY

SEP 4 1977

Ph Flw 141 Bopd
+ 2% wts gran 430

10-33-3E

C 56