


Ellis

KANSAS

SECTION 3 TOWNSHIP 13 RANGE 17W

WELL NO. #1 Walter

COMPANY Earl F. Wakefield

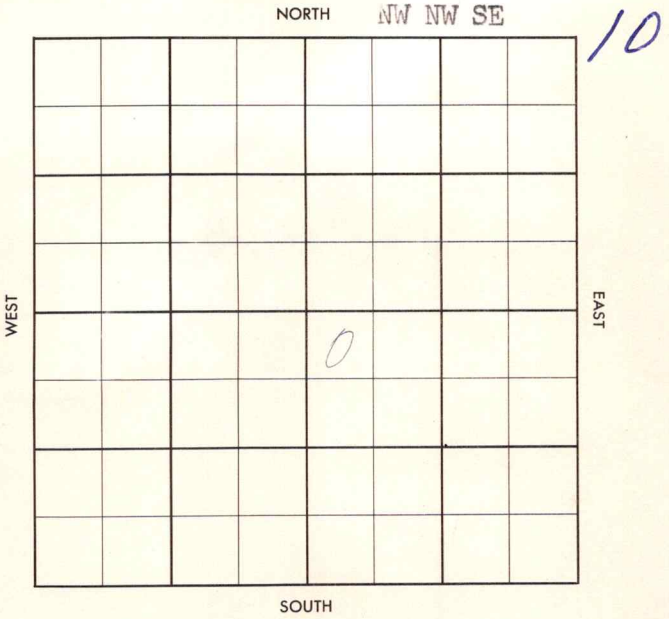

County Ellis Elev. _____
 Sec. 3 Twp. 13 Rgs. 17W
 Company Earl F. Wakefield
 Farm Name Walter No. 1

TOPS	DEPTH	LOG	DATUM	Loc. in Sec.
Anh.				NW NW SE
Tp.				
H.				
Tr.				
Dg.				
Bl.				
L.				Geol.
K.C.				Contr.
B.K.C.				Co. Tools
Ce.				Pool
C.				Catharine
M.				
M.				
K.				
Mz.				
Me.				
V.				
S.				
S.				
A.				
R.				
Pe.				
G.				
T.D.				

FIRST REPORT
 APR 3 1957

Date Comm. 3-31-57
8" @ 150, Drlg. 1200

14

County Ellis Elev. 2025
 Sec. 3 Twp. 13 Rge. 17W
 Company Earl F. Lakefield
 Farm Name Walter No. 1

TOPS	DEPTH	LOG	DATUM	Loc. in Sec.
Anh.				NW NW SE
TP.				
H.	3226			
Tr.	3256			
Dg.				
Bl.				
L.	3281			Geol.
K.C.				Contr.
B.K.C.				Co. Tools
Ce.				Pool
C.				Catharine
M.				
M.				
K.				
Mz.				
Ma.				
V.				
S.				
S.				
A.	3532			
R.				
Pf.				
G.				
TD.	3577			

COMPLETE
 0
 JUN 12 57

Date Comm. 3-31-57

8" @ 150, Drlg. 1200 APR 10 57 DST

3299-3328 1hr run 110' HSCM

BHP 870/30" DST 3327-53

1hr 15' oil B + 35' 50 E

MC SW BHP 310 DST 3359

-96 APR 17 57 op 1hr 50' oil + 50'

Mdy BHP 375/20 DST 3396-

3441 1hr 70' OCM NO BHP?

DST 3522-47 1hr 3' oil + 12' Md

BHP 50

DST 3547-60 1hr 30' Md
 BHT 0 DST 3547-77 1hr
 no rec. BHT 0 5 1/2 @ 3542
 WOCT APR 24 '57 M. L. T. MAY 1 '57 ✓ MAY 13 '57

P. 6 3416-20 1/2 +st 2 Boph
 16/3350-60 1/2 +st 2 Boph
 16/3330-32 1/2 +st 5 Boph
 no/w 16/3312-16 1/2 +st 5
 Boph P. 6 Boph no/w.
 All 2n's open. MAY 22 '57

P. MAY 29 '57 JUN 5 '57 X WO ST +st JUN 12 '57
 X Ph P. 56 Boph + 5%
 wtr