

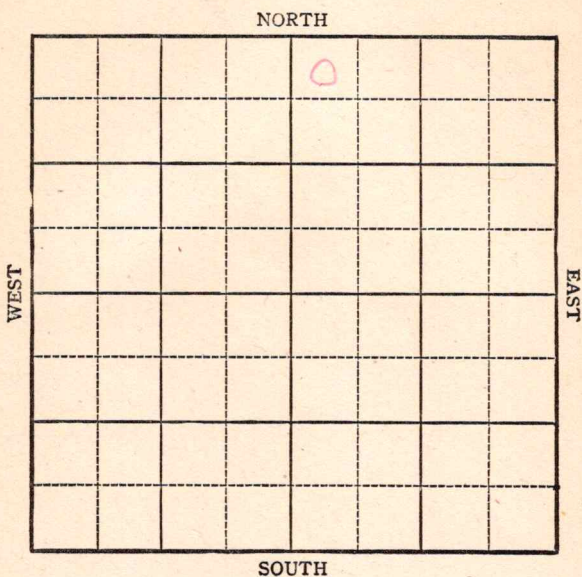
KANSAS

Ellis County

Section 4 Township 13 Range 17W

Well No. #1 Madden

Company Max Cohen



KANSAS

Ellis County

Sec. 4 Twp. 13 R. 17WWell No. #1 Madden FarmMax Cohen

Company

Wildcat

330

Ft. from N. Line

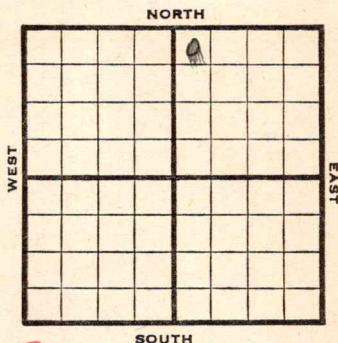
Ft. from S. Line

Ft. from E. Line

330

Ft. from W. Line

NW NE

6 lev. 2072

1944

R E P O R T

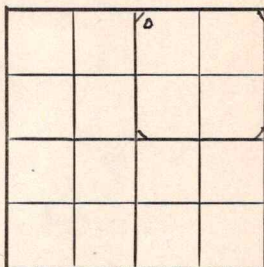
11/8	S H
11/16	10" @ 116' Drlg. 2760'
11/24	topeka 3100 Lans 3324 Arb 3582 88 T. D. 5" @ 3583 RUST
11/29	1000 accid testing
12/6	TD 3614 2400' accid
12/14	TD 3614 2400' oil
12/21	" " " "
12/29	" " " "
1945	
1/3	" " " "
1/10	" " " "
1/17	" " " "
1/26	" " " "
1/31	Arb. 3582 5" @ 3583 TD 3614 Pump 106 oil Pot Grav. 32.0

COMPLETED

Pool Name WildcatMap No. 71 Sec. 4 Twp. 13 R. 17WWell No. 1 MaddenMax Cohen CompanyFIRST REPORT Contractor

NW NE

SECTION PLAT

330 Ft. from N. Line Ft. from S. Line Ft. from E. Line330 Ft. from W. LineEllisLocation Rig up

Drilling and Remarks:

S H

RECORD

Cased in., ft.Sand Gas Oil Total Depth

PRODUCTION

1st 24 hrs. Nat. 1st 24 hrs. after shot Gas Cu. Ft.Dry Hole Abandoned

Date

NOV 8 1944 19S. J. LEWIS Scout

Pool Name CatherineMap No. 71 Sec. 4 Twp. 13 R. 17WWell No. 1 MaddenMax Cohen

Company

COMPLETED

Contractor

NW NE

SECTION PLAT

		o	

330 Ft. from N. Line

Ft. from S. Line

Ft. from E. Line

330 Ft. from W. LineEllis County

Location

Rig up

Drilling and Remarks:


Cased _____ in., _____ ft.

Sand _____

Gas _____

Oil _____

Total Depth 3614**PRODUCTION**

1st 24 hrs. Nat. _____

1st 24 hrs. after shot _____

Gas _____ Cu. Ft.

Dry Hole _____

Abandoned _____

Date

JAN 31 1945

19

S. J. LEWIS

Scout