


KANSAS

Russell

Section 30 Township 12S Range 15W

Well No. #6 Deckert

Company Sohio et al

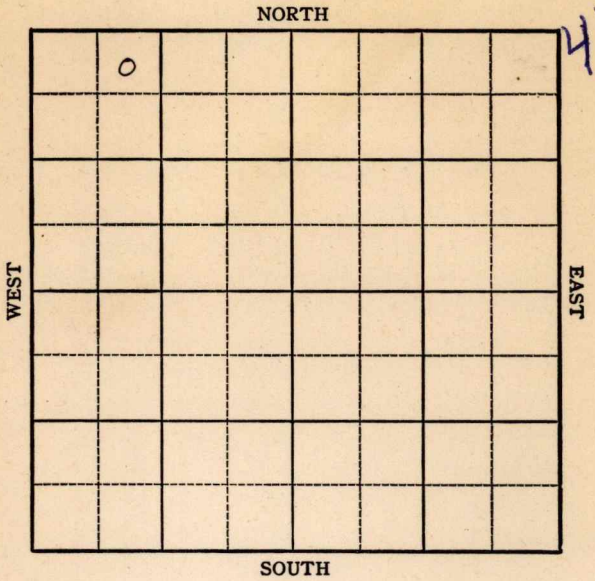

Sec. 30 Twp. 12 R. 15W ✓

Well No. #6 Deekert Farm

Sohio et al Company

Fairport

330'

Ft. from N. Line


Ft. from S. Line

Ft. from E. Line

990'

Ft. from W. Line

NE NW NW

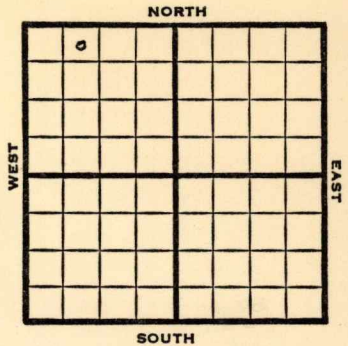

1949

Elev 1898' REPORT

2/9

Anhy. 948'

Drlg. 958'

2/16

Drlg 2620'

2/23

Topeka 2704'

Lansing 3021'

Reagan 3300'

Granite Wash 3303-04'

TD 3304'

5"@ 3300'

3/2

TD 3304'

Reagan 3300'

Granite Wash 3303'

5"@ 3300'

Pump 50 Oil

36° Gr.

Comp

COMPLETED

Kansas

Fairport

Map No. _____ Sec. 30 Twp. 12 R. 15 W

Well No. 6 Decker

Sohio Etal Company

FIRST REPORT

Contractor

NEHWNW

SECTION PLAT

<u>0</u>			

330 Ft. from N. Line

_____ Ft. from S. Line

_____ Ft. from E. Line

990 Ft. from W. Line

Russell

Location _____

Rig up _____

Drilling and Remarks:

*any 948'
958'*

RECORD

Cased _____ in., _____ ft.

Sand _____

Gas _____

Oil _____

Total Depth _____

PRODUCTION

1st 24 hrs. Nat. _____

1st 24 hrs. after shot _____

Gas _____ Cu. Ft.

Dry Hole _____

Abandoned _____

Date

FEB 9 1949 19 _____

Scout

Kansas

Map No. K72 Sec. 30 Twp. 12 R. 15W

Well No. 6 Deckert

Sohio etal. Company

COMPLETE Contractor

NE NW NW

E. 11898

SECTION PLAT

0			

330 Ft. from N. Line

 Ft. from S. Line

 Ft. from E. Line

990 Ft. from W. Line

Russell County

Location

Rig up

Drilling and Remarks:

Reagan 3300
Granite Wash 3303
5" @ 3300
Pump 50 oil

RECORD

Cased in., ft.

Sand

Gas

Oil

Total Depth 2904

PRODUCTION

1st 24 hrs. Nat.

1st 24 hrs. after shot

Gas Cu. Ft.

Dry Hole

Abandoned

36 @ 34

Date

MAR 2 1949 19

S. J. LEWIS Scout