

Cowley


KANSAS

SECTION 10 TOWNSHIP 33 S RANGE 3 E

WELL NO. # 6 Bradbury

COMPANY Crest Petroleum

Appx C E/2 ~~NE~~<sup>NORTH</sup> SE

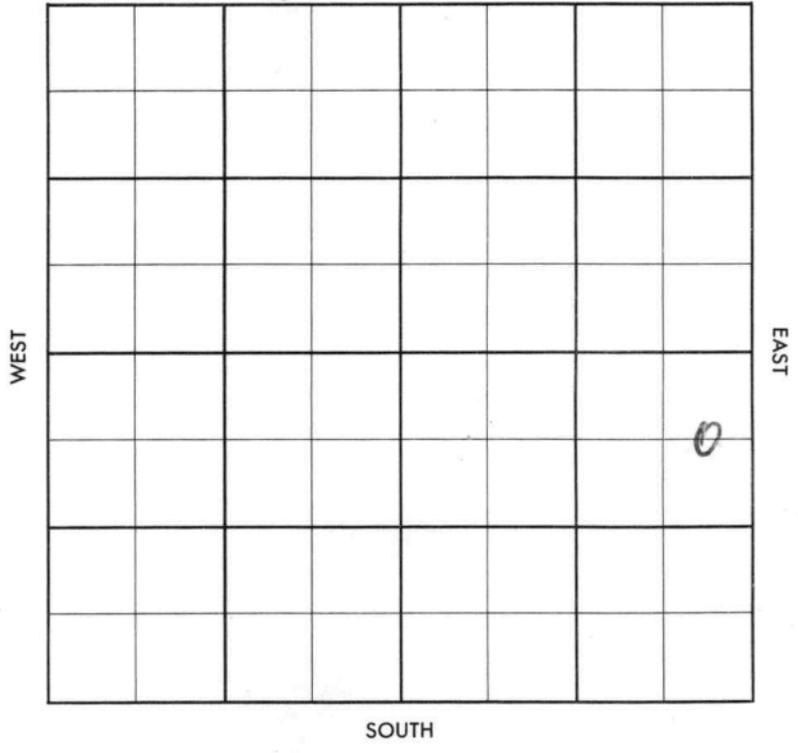

County Cowley

Elev. \_\_\_\_\_

Sec. 10

Twp. 33

Rgs. 3  
~~SE~~

Company Crest Petroleum

Farm Name Bradbury

No. 6

TOPS

DEPTH

LOG

DATUM

Loc. in Sec. \_\_\_\_\_

Anh.				App C E/2 NE SE
TP.				
H.				550' fnl x
Tr.				330' fel SE/4
Dg.				
Bl.				
L.				Geol. _____
K.C.				Contr. _____
B.K.C.				Co. Tools _____
Ce.				
C.				Pool _____
M.				Graham
M.				
K.				
Mz.				
Me.				
V.				
S.				
S.				
A				
R.				
PC.				
G.				
TD.				

FIRST REPORT	
	O
AUG 28 '37	

Date Comm. \_\_\_\_\_

RURT

*29*

Co.

Lse.

No.

Sec.

T.

R.

~~29~~  
CORRECTION

FORM 513 SUNRAY

County Cowley Elev. \_\_\_\_\_  
 Sec. 10 Twp. 33 Rgn. SE 3E  
 Company Crest Petroleum  
 FarmName Bradbury No. 6

TOPS	DEPTH	LOG	DATUM
Anh.			
Tp. <u>Sta 1A</u>	<u>2122</u>		
H. <u>bay</u>	<u>2610</u>		
Tr.			
Dg.			
Bl.			
L.			
K.C.	<u>2782</u>		
B.K.C. <u>DSWC</u>	<u>2924</u>		
Ce.	<u>3084</u>		
C.			
M. <u>chert</u>	<u>3242</u>		
M.			
K.			
Mz.			
Ma.			
V.			
S.			
S.			
A.			
R.			
Pe.			
G.			
T.D.	<u>3251</u>		

Loc. in Sec. App C E/2 NE SE  
550' fnl x  
330' fel SE/4  
 Geol. \_\_\_\_\_  
 Contr. \_\_\_\_\_  
 Co. Tools \_\_\_\_\_  
 Pool \_\_\_\_\_  
Graham  
 COMPLETE  
 OCT 16 '57

Date Comm. RURT SEP 4 '57 X Spud 8-29-57  
8 5/8 107 # 2812 SEP 11 '57  
5 1/2 3244 CO ERAC  
F10 65 BOPH nowtr SI  
for tanks SEP 25 '57 OCT 2 '57 OCT 9 '57  
 OCT 16 '57 F10 25 BOPD