DX 78-1

Cowley

KANSAS

Section 10 Township 33 Range 3E

Well No. #1 M.A. Nixon

Company Frank Taylor

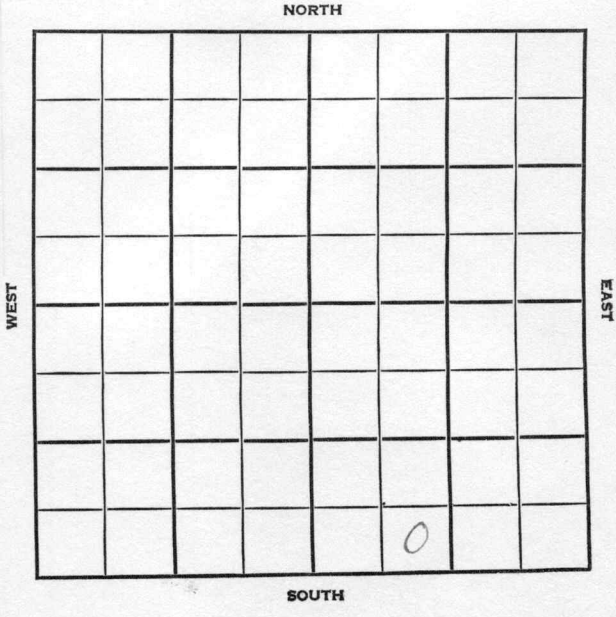

FORM 513 SUNRAY

County Cowley Elev.

Sec. 10 Twp. 33 Rge. 3E

Company Frank Taylor

Farm Name M.A. Nixon No. 1

TOPS	DEPTH	LOG	DATUM
Anh.			
Tp.			
H.			
Tr.			
Dg.			
Bl.			
L.			
K.C.			
B.K.C.			
Ce.			
C.			
M.			
M.			
K.			
Mz.			
Mq.			
V.			
S.			
S.			
A			
R.			
P€.			
G.			
T.D.			

Loc. in Sec. SE SW SE

Geol.

Contr. Crisswell Tools

Pool Graham

DEC 5 36

FIRST REPORT

Date Comm.

Location

Co.

No.

Sec.

T.

R.

FORM 513 SUNRAY

County Cowley Elev.

Sec. 10 Twp. 33 Rge. 3E

Company Frank Taylor

Farm Name M.A. Nixon No. 1

TOPS	DEPTH	LOG	DATUM
Anh.			
Tp.			
H. Stall	2200		
Tr. Lay	2606		
Dg.			
B.L.			
L. Marm	2961		
K.C.			
B.K.C.			
Ce.			
C.			
M. Char	3239		
M.			
K.			
Mz.			
Mo.			
V.			
S.			
S.			
A			
R.			
P€.			
G.			
T.D.	3250		

Loc. in Sec. SE SW SE

Geol.

Contr. Crisswell Tool

Pool Graham

COMPLETE

APR 3 '57

0

Date Comm.

Location DEC 12 '56 DEC 19 '56 12-13-56

8 5/8 80/25 @ 2336 DEC 26 '56

DST 3240-50 1 hr. G/6" new

250 clean oil + 65' HOCM FP

15-100 BHP 1140 /30" 5½

3243 CO 3250 F/9. JAN 2 '57

JAN 9 '57 JAN 15 '57 ✓ JAN 23 '57

Flw est 10 Boph thru csg

Frac 5x5 Flw 35 Boph no wtr Plug

JAN 30 '57

Co. Lse. No. Sec. T. R.

FORM 513-1 SUNRAY

FEB 6 '57 FEB 13 '57 FEB 20 '57 FEB 27 '57 MAR 6 '57

MAR 13 '57 F 20 BOTH 3/4" ℄ 24 hrs

MAR 20 '57 MAR 27 '57 APH 3 '57 Ph Flow

341 Bopd + 4/10 % wtr.

10-33-3E