


Russell

Map No. Sec. 30 Twp. 12 R. 15-W
 Well No. 33 - Ginther Farm
Mid-West Company

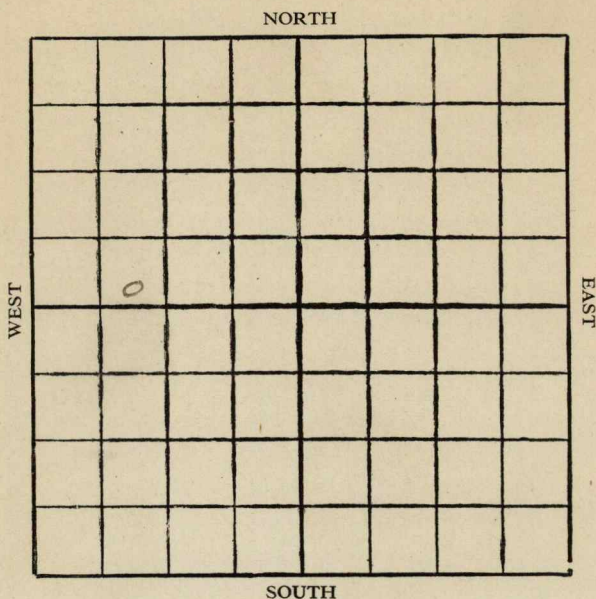

Location

Drilling Remarks

Rig Up

Drilling Remarks

RECORD

Cased in. ft.

Sand

Gas

Oil

Total Depth

PRODUCTION

1st 24 hrs. Nat.

1st 24 hrs. after shot

Gas cu. ft.

Dry Hole

Abandoned

Russell

Map No. 15 Sec. 30 Twp. 12 R. 15 W

Well No. 33 - Gunther Farm

Mid-west Company


Ft. from N. Line

200 Ft. from S. Line

Ft. from E. Line

990 Ft. from W. Line

1927

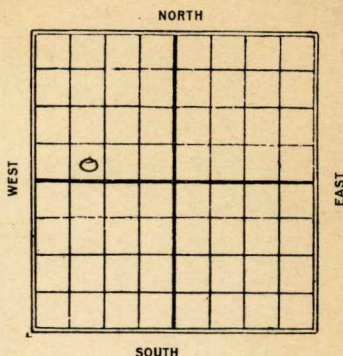

Date

REPORT

1/5	Location
1/12	cellar
1/19	Rig bldg
1/26	spud
2/2	Drlg 300
2/9	T. D. 535 fishing tailer
2/16	Drlg-560
2/23	" 1000
3/2	" 1600
3/9	" 2116
3/16	" 2348
3/22	" 2590
3/30	" 2745
4/6	Top Oswald sand 3046 - water T. D. 3120 - U. R. 6"
4/13	T. D. 3120 - drilling up U. R. logs
4/20	Drlg 3220
4/27	3274 - 78 - 25 bbl. showing Drlg 3285 -
5/4	" 3377
5/11	" 3400
5/18	T. D. 3470 - fishing tools
5/25	

6/1- P. B. to 3318-

6/8 _____

6/15 _____

6/22 - T.S. 3274

or 3278

T.D. 3327

5 bbl jumper
to hold the lease

Map No. _____ Sec. 30 Twp. 12 R. 15W

Well No. 33 Ginther

Mid West. Company

Contractor

SECTION PLAT

_____ Ft. from N. Line

300 Ft. from S. Line

_____ Ft. from E. Line

990 Ft. from W. Line

FIRST REPORTS

Location ✓

Rig up _____

Drilling and Remarks:

RECORD

Cased _____ in., _____ ft.

Sand _____

Gas _____

Oil _____

Total Depth _____

PRODUCTION

1st 24 hrs. Nat. _____

1st 24 hrs. after shot _____

Gas _____ Cu. Ft.

Dry Hole _____

Abandoned _____

Date

JAN 5 1927

S. J. LEWIS

Scout




Contractor

SECTION PLAT

----- Ft. from N. Line

300 Ft. from S. Line

----- Ft. from E. Line

990 Ft. from W. Line

0			

COMPLETED

Location -----

Rig up -----

Drilling and Remarks:





to hold the
Lease

RECORD

Cased ----- in., ----- ft.

Sand -----

Gas -----

Oil -----

Total Depth -----

PRODUCTION

1st 24 hrs. Nat. -----

1st 24 hrs. after shot -----

Gas ----- Cu. Ft.

Dry Hole -----

Abandoned -----

Date

JUN 22 1927

S. J. LEWIS

Scout