


Section 31 Township 12 Range 15W

Well No. #1 A. C. Roggs

Company Stearns Drlg.

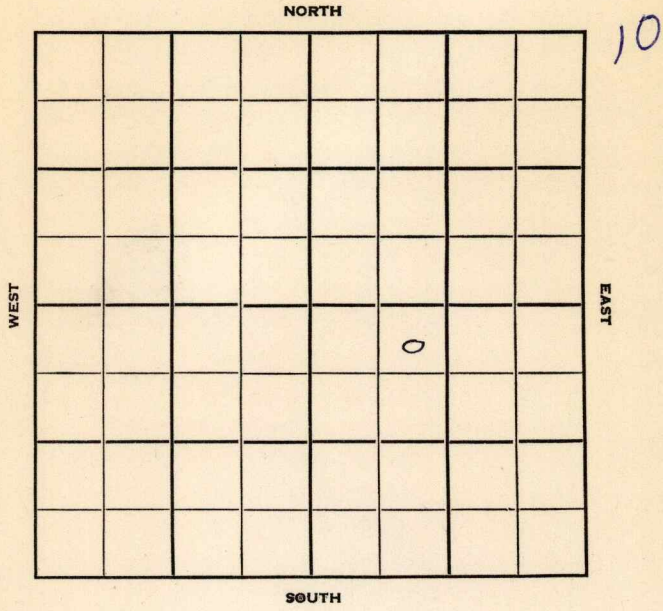

Russell

Sec. 31 Twp. 12 R. 15W

Well No. #1 A. C. Roggs Farm

Stearns Drlg. Company

Stearns Contractor

Fairport


330 Ft. from N. Line

_____ Ft. from S. Line

_____ Ft. from E. Line

990 Ft. from W. Line

NE NW SE

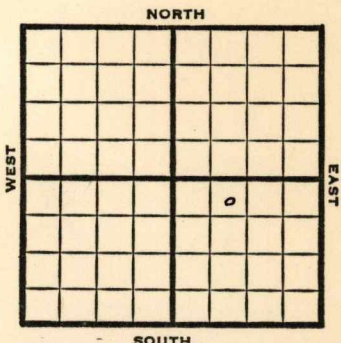

1952 **Elev. 1880'**

REPORT

3/5 Spud 2-28-52

Anhy 900'

Drlg. 2000'

3/12 **8" @ 275'**

Drlg. 2915'

3/19 Spud 2-28-52

D&A TD 3389

Anhy 900' 8" @ 275 Top. 2726

Heeb. 2991 Lans. 3035 Cong. 3321

DST 3321-38 open $\frac{1}{2}$ hr. rec. 10' mud

Arb. 3347-89 TD

D&A

ABANDONED

County **Russell** State **Kansas**

Sec. **31** (Blk. Twp.) **12** (Sur. Rge.) **15W** Map No.

Operator **Stearns Drlg.**

Well No. **1** Farm **A. C. Roggs**

Elev. Location **NE NW SE**

FIRST REPORT

330 Ft. From **N** Line **SE**

990 Ft. From **W** Line Quarter

1st. Report **MAR 5 1952**

Completion

Remarks

Stearns - Contr.

Spudding Date **2-28-52**

Drlg. Data **Fairport**

Anhy 900 Drlg. 2000

