

KANSAS


Barton

Form 51-5M-7-40-Palace

Section 24 Township 17 Range 12-W

Well No. #1 Beran

Company C.R. Piggott, Johnson & Benson Drlg.

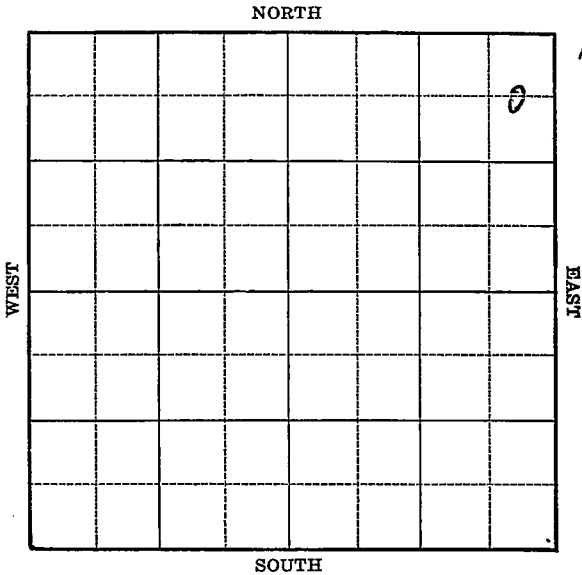

Map No. 55 Sec. 24 Twp. 17 R. 12WWell No. 1 BeranC.R. Piggott, Johnson & Benson Drig.
Company

Contractor


FIRST REPORT

C E L NE NE

660 Ft. from N. Line Ft. from S. Line330 Ft. from E. Line Ft. from W. Line

WILDCAT

SECTION PLAT

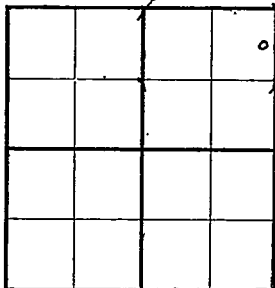Location Rig up

Drilling and Remarks:

Machine

RECORD

Cased in., ft.Sand Gas Oil Total Depth

PRODUCTION

1st 24 hrs. Nat. 1st 24 hrs. after shot Gas Cu. Ft.Dry Hole Abandoned

Date

DEC 23 1940 19 S. J. LEWIS Scout

Map No. 55 Sec. 24 Twp. 17 R. 12WWell No. 1 BeranC. R. Piggott, Johnson Company
& Benson Drilling
Contractor

ABANDONED

SECTION PLAT

C E L N E N E

660 Ft. from N. Line Ft. from S. Line330 Ft. from E. Line Ft. from W. Line

WILDCAT

Location Rig up

Drilling and Remarks:

*Cr & 3335**Water*

RECORD

Cased in., ft.Sand Gas Oil Total Depth 3367

PRODUCTION

1st 24 hrs. Nat. 1st 24 hrs. after shot Gas Cu. Ft.Dry Hole Abandoned

Date

FEB 5 1941 19

S. J. LEWIS Scout