

Ellis

FORM 51 5M PETROL


5M PETROL
O. W. D. D

Section 4 Township 13 Range 17W

Well No. 1 Walters

Company H & H Drilling
Ashland O & Ref.

NORTH

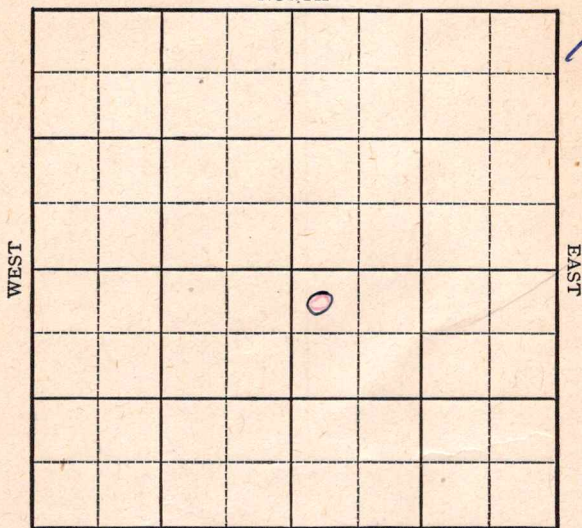

SOUTH

O. W. D. D

KANSAS

Ellis

Sec. 4 Twp. 13 R. 17-W ✓


Well No. #1 Walters Farm
H & H Drilling
Ashland O & Ref. Company

330 Ft. from N. Line

Ft. from S. Line

Ft. from E. Line

330 Ft. from W. Line

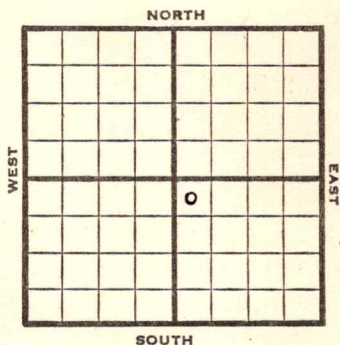

NW SE

1945 **Elev. 2056'** REPORT

9/5 Location

9/12 RUR

9/19 8" @ 1250

Anhy. 1245

Drlg. 2205

9/26 Drlg. 3202

10/3 **Lans 3326**

Arb. 3582-3585

TD 3585 SO

5" @ 3583 RUST

10/10 TD 3590

5" @ 3588 corrected

10/17 TD 3594

1500 acid.

Swab 17 oil per hr. 8 hrs.

10/24 " " " "

10/31 " " " "

11/7 " " " "

11/14 " " " "

11/21 **Arb. 3582**

5" @ 3588

1500 acid.

TD 3594

Pump 62 oil plus 60 Wtr. Pot.

Grav. 28.9

COMPLETED

OVER

1951
9/12

O. W. D. D

719426

OWDD for SWD

Lans 3323', Arb. 3582' TD 3590'
5" @ 3588' Was Oil Prod.
Drilling 3748' for SWD

10/3 SWD well TD 3867'

Lans. 3323' Arb. 3582' OTD 3590'

5" @ 3588' DD 3867' 5000 A

Comp. for SWD well.

ABANDONED

KANSAS
KansasPool Name CatherineMap No. 71 Sec. 4 Twp. 13 R. 17WWell No. 1 WaltersAshland O & Ref.

Company

FIRST REPORT

Contractor

NW SE

SECTION PLAT330 Ft. from N. Line Ft. from S. Line Ft. from E. Line330 Ft. from W. Line

		0	

Ellis CountyLocation XRig up

Drilling and Remarks:

RECORDCased in., ft.Sand Gas Oil Total Depth **PRODUCTION**1st 24 hrs. Nat. 1st 24 hrs. after shot Gas Cu. Ft.Dry Hole Abandoned

Date

SEP 5 1945 19S. J. LEWIS

Scout

KANSAS

Kansas

Pool Name CatherineMap No. 71 Sec. 4 Twp. 13 R. 17WWell No. 1 WaltersAshland Oil & Ref.

Company

COMPLETED


Contractor

NW SE

E12056
SECTION PLAT330 Ft. from N. Line

Ft. from S. Line

Ft. from E. Line

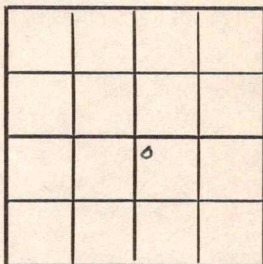330 Ft. from W. Line

Ellis County

Location

Rig up

Drilling and Remarks:

Per 785825' @ 35881500 @ 200Pump 62 oil + 60 WRef2834**RECORD**

Cased _____ in., _____ ft.

Sand _____

Gas _____

Oil _____

Total Depth 8594**PRODUCTION**

1st 24 hrs. Nat. _____

1st 24 hrs. after shot _____

Gas _____ Cu. Ft.

Dry Hole _____

Abandoned _____

Date

NOV 21 1945

19

S. J. LEWIS

Scout

County Ellis State Kansas
 Sec. 4 (Blk.) 13 (Sur.) 17W Map No.
 Operator H & H Drilling (was Ashland)
 Well No. 1 Farm Walters
 Elev. Location NW NW SE

FIRST REPORT

0

330 Ft. From N Line SE
330 Ft. From W Line Quarter
 1st. Report SEP 12 1951

Completion

Remarks OWDD for Swd.
O. W. D. D

Spudding Date

Drlg. Data

Lans 3323 arb 3582 TD 3590 5" @ 3588

was oil pred. Drlg. 3748 for swd.

J. E. TYRA

J. E. TYRA