FORM 51 10M 8-47

Barton

KANSAS


Section 30 Township 17 Range 12W

Well No. #1 Demel

Company Ben Brack

Wildcat

3

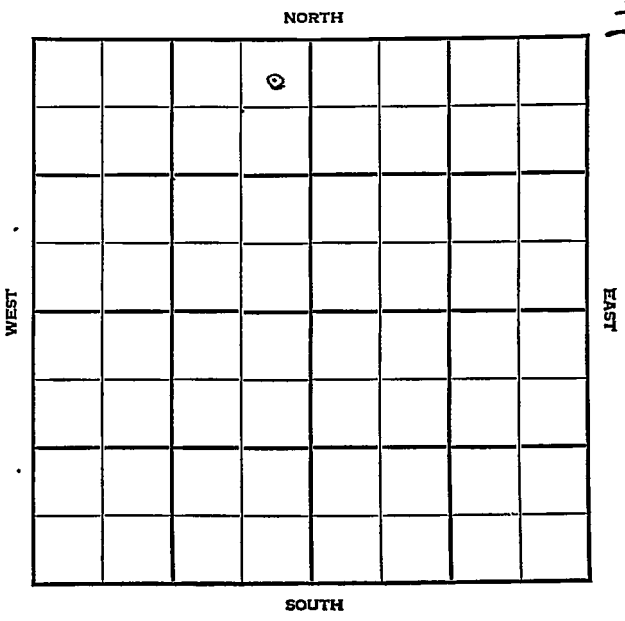

FORM 252-A
5M 12-45 PETROL

KANSAS

Barton County ✓

Sec. 30 Twp. 17 R. 12W

Well No. #1 Demal Farm

Ben Brack Company

Wildcat


330 Ft. from N. Line

Ft. from S. Line

330 Ft. from E. Line

Ft. from W. Line

NE NW

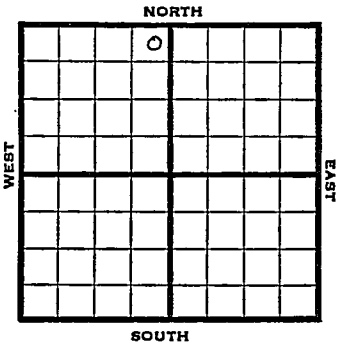

1948	Elev. 1873' REPORT
4/21	Location
4/28	RUR
5/5	8" @ 150' Drlg. 3085'
5/12	Lansing 3157' Arb. 3394' TD 3470' Abd.

ABANDONED

Form 26—200 Bks.—1-48—Palace

Wildcat

Kansas

Map No. _____ Sec. 30 Twp. 17 R. 12W


Well No. 1 Demel

Ben Brack Company

FIRST REPORT Contractor

NE NW

SECTION PLAT

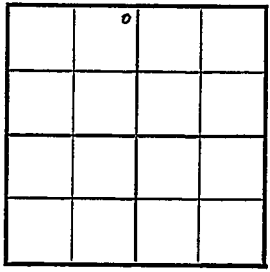

330 Ft. from N. Line

_____ Ft. from S. Line

330 Ft. from E. Line

_____ Ft. from W. Line

Barton County

Location X

Rig up _____

Drilling and Remarks:

RECORD

Cased _____ in., _____ ft.

Sand _____

Gas _____

Oil _____

Total Depth _____

PRODUCTION

1st 24 hrs. Nat. _____

1st 24 hrs. after shot _____

Gas _____ Cu. Ft.

Dry Hole _____

Abandoned _____

Date

APR 21 1948 19____ S. J. LEWIS Scout

Form 26—200 Bks.—1-48—Palace

Wildcat

Kansas

Map No. 55 Sec. 30 Twp. 17 R. 12W

Well No. 1 Demel

Ben Brach Company


ABANDONED

Contractor

NE NW

E.1873

SECTION PLAT

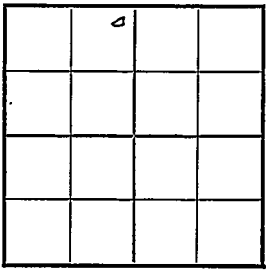

330 Ft. from N. Line

____ Ft. from S. Line

330 Ft. from E. Line

____ Ft. from W. Line

Barton County

Location

Rig up

Drilling and Remarks:

Lane 3859.

Ary 8394

RECORD

Cased ____ in., ____ ft.

Sand

Gas

Oil

Total Depth 3470

PRODUCTION

1st 24 hrs. Nat.

1st 24 hrs. after shot

Gas ____ Cu. Ft.

Dry Hole

Abandoned

Date

MAY 12 1948 19____

S. J. LEWIS Scout