


Map No. KANSAS Sec. 31 Twp. 12 R. 15^w
 Well No. 18-Byumgardt Farm
Mid West Company

NORTH

WEST

EAST

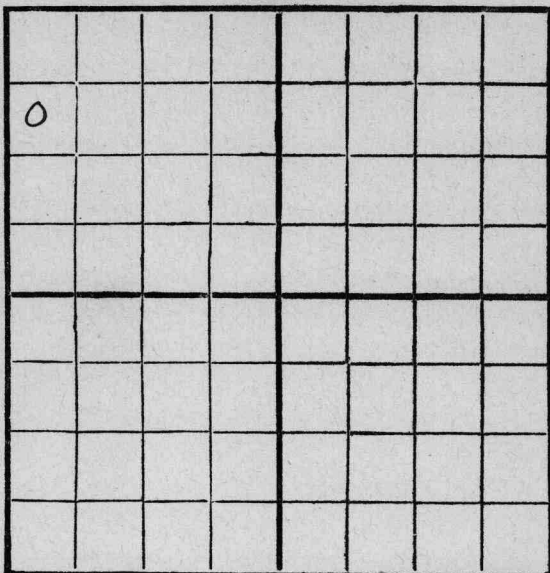

SOUTH

Location _____

Drilling Remarks

Rig Up _____

Drilling Remarks

RECORD

Cased _____ in. _____ ft.

Sand _____

Gas _____

Oil _____

Total Depth _____

PRODUCTION

1st 24 hrs. Nat. _____

1st 24 hrs. after shot _____


Gas _____ cu. ft. _____

Dry Hole _____

Abandoned _____

Map No. KANSAS Sec. 31 Twp. 12 R. 15^w
 Well No. 18- Bumpgardt Farm
midwest Company

NORTH

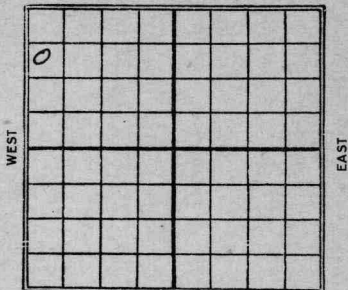

SOUTH

990 Ft. from N. Line

_____ Ft. from S. Line

_____ Ft. from E. Line

330 Ft. from W. Line

Date REPORT

8/28 Bldg Rig
 9/4 —
 9/11 Rig
 9/18 Wly 695
 9/25 " 1115
 10/2 " 1965'
 10/9 VTR 8" 2430'
 10/16 sand 2478-88 1H gas
 1H gas at 2566-72
 6" 2566 Wly 2585
 10/23 Wly 2760'
 10/30 Top Oswald 3057'
 T.D. 3074' H.F. oil
 No Test
 11/6 Pay 3057-91'
 T.D. 3091'
 swab 581 bbls oil
 @ 41² gravity
 Comp.
 1931 OWDD
 11/18 Old T.D. 3091
 Increase 3093-97
 Wreg 3/11

11/24 - Deepened to
TD. 3148

Swab 220 bbl 24 hr

12/2 - TD. 3148

Swab 50 bbl day

12/9 - TD. 3178

Swab 43 bbl per day

12/16 - Deepened to
TD. 3178

Made 70 bbl oil
Comp.

Map No. KANSAS Sec. 31 Twp. 12 R. 15W

Well No. 77 18 Bungalow St.

Mid West Company

Contractor

SECTION PLAT

990 Ft. from N. Line

_____ Ft. from S. Line

_____ Ft. from E. Line

330 Ft. from W. Line

0			

FIRST REPORTS

Location _____

Rig up _____

Drilling and Remarks:

Building rig

RECORD

Cased _____ in., _____ ft.

Sand _____

Gas _____

Oil _____

Total Depth _____

PRODUCTION

1st 24 hrs. Nat. _____

1st 24 hrs. after shot _____

Gas _____ Cu. Ft.

Dry Hole _____

Abandoned _____

Date

AUG 28 1922

S. J. LEWIS Scout

Map No. KANSAS Sec. 31 Twp. 12 R. 15W

Well No. 72 18 Bungalow St.

Mich. West Company

Contractor

SECTION PLAT

990 Ft. from N. Line

_____ Ft. from S. Line

_____ Ft. from E. Line

380 Ft. from W. Line

COMPLETED

0			

Location _____

Rig up _____

Drilling and Remarks:

Pay. 3057-91

Qwa 88 581 884

41.2 gravity

RECORD

Cased _____ in., _____ ft.

Sand _____

Gas _____

Oil _____

Total Depth 3091

PRODUCTION

1st 24 hrs. Nat. _____

1st 24 hrs. after shot _____

Gas _____ Cu. Ft.

Dry Hole _____

Abandoned _____

Date

NOV 6

1929

192

S. J. LEWIS

Scout

Russell

72 KANSAS Sec. 31 Twp. 12 R. 15^WWell No. 18 Brungard
Mid-West Company

Contractor

FIRST REPORTS


SECTION PLAT

990 Ft. from N. Line

Ft. from S. Line

Ft. from E. Line

330 Ft. from W. Line

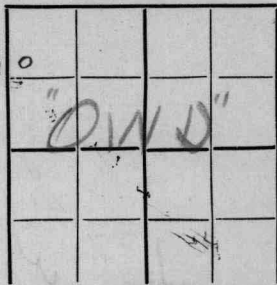

Location

Rig up

Drilling and Remarks:

Hd TD 3091

increase 3093-97

By 3111

RECORD

Cased in., ft.

Sand

Gas

Oil

Total Depth

PRODUCTION

1st 24 hrs. Nat.

1st 24 hrs. after shot

Gas Cu. Ft.

Dry Hole

Abandoned

Date

NOV 18 1931

CHAS. L. SHERWOOD

192

Scout

72 KANSAS

Map No. _____ Sec. 31 Twp. 12 R. 15 ^WWell No. 18 BrungartMid. West

Company _____

Contractor _____

COMPLETED

SECTION PLAT

990 Ft. from N. Line

_____ Ft. from S. Line

_____ Ft. from E. Line

330 Ft. from W. Line

0			

Location _____

Rig up _____

Drilling and Remarks:

Old TD 3091
Deepened to 3178
70 Bbls.

RECORD

Cased _____ in., _____ ft.

Sand _____

Gas _____

Oil _____

Total Depth 3178

PRODUCTION

1st 24 hrs. Nat. _____

1st 24 hrs. after shot _____

Gas _____ Cu. Ft.

Dry Hole _____

Abandoned _____

Date

DEC 16 1931 CHAS. L. SHERWOOD

192

Scout