

DX 78-1


Barton

KANSAS

Section 24 Township 17 Range 12 W

Well No. # 1 F. Beran

Company Lohman & Johnson

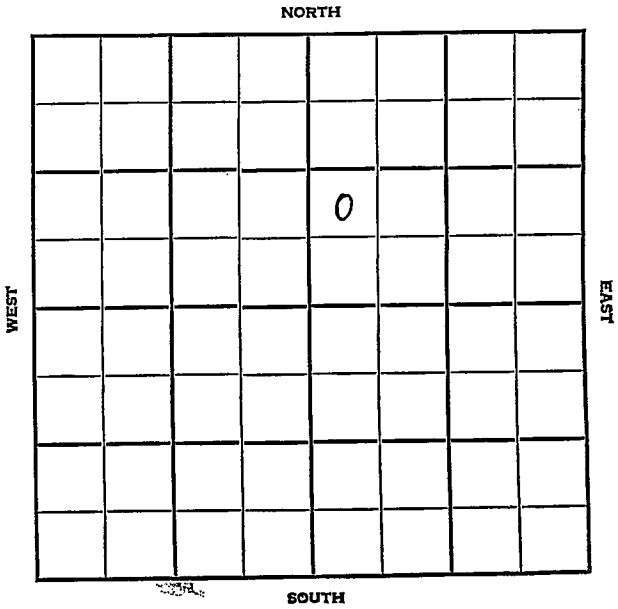

Barton KANSAS


SEC.	TWP.	R.
24	17	12W ✓

WELL NO. _____
 COMPANY **1 F. Beran** FARM

CONTRACTOR **Lohman & Johnson**

Wildcat

_____ Ft. from N. Line
 990 _____ Ft. from S. Line
 _____ Ft. from E. Line
 330 _____ Ft. from W. Line

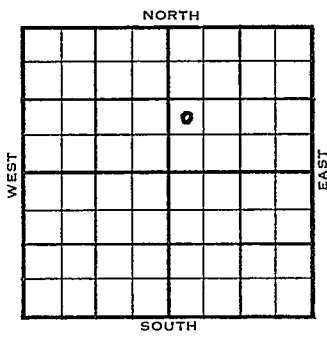

NW SW NE

1954	ELEVATION 1855'	REPORT
------	--------------------	--------

5/19 Location
 Spud 5-17-54

6/2 Spud 5-17-54 D & A TD 3390
 Heeb 2952 Tor. 2972 Br. lime 3053
 Lans. 3071 Cong. 3318
 DST 3320-40 open 1 hr rec 75' SOCM
 565#
 DST 3318-55 open 1 hr rec 70' SOCM
 560# Arb. 3365 TD 3390 D & A

ABANDONED

