


Section 4 Township 13 Range 17W

Well No. #1 Walter

Company W. L. Hartman

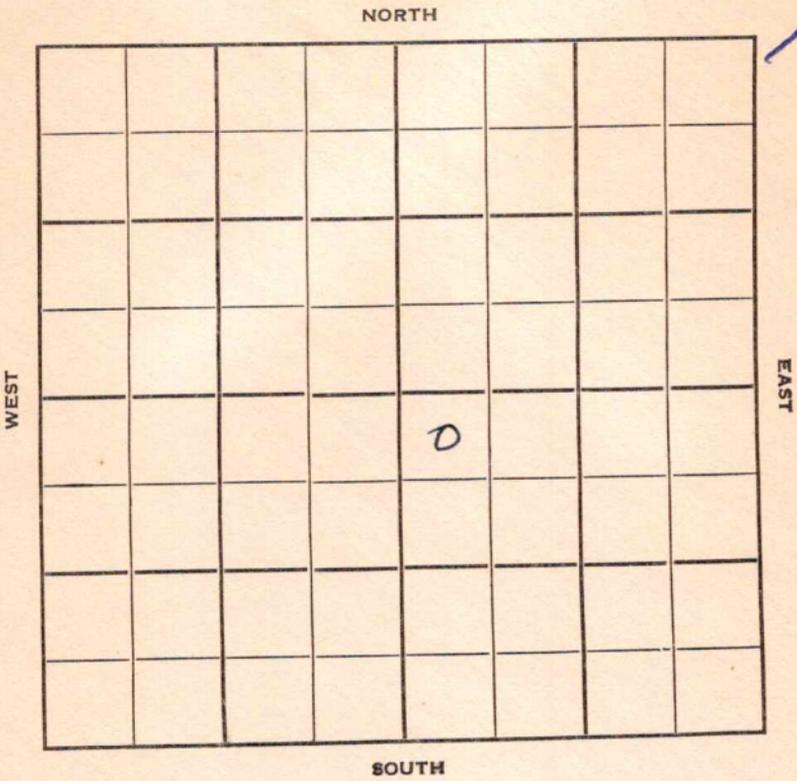

Sec. 4 Twp. 13 R. 17W

Well No. #1 Walter Farm

W. L. Hartman Company

Catherine NW


330' Ft. from N. Line

_____ Ft. from S. Line

_____ Ft. from E. Line

³⁷⁵
330' Ft. from W. Line

NW NW SE

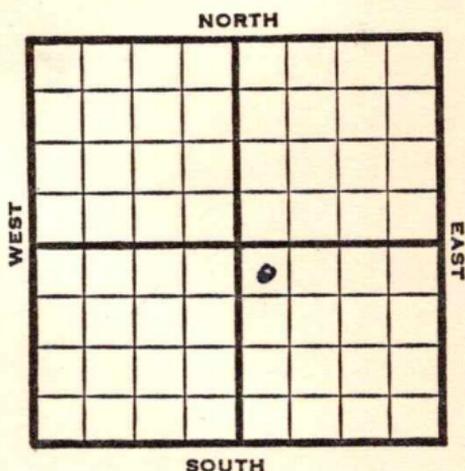

1950

Elev. 2056'

R E P O R T

1/4

RUR

7/26

5" @ 3632
15/3480-85
12/3500-08
500 acid
B/5½ gw 1½ goph
PB 3450
24/3415-24, 12/3410-14, 5/3406-08
23/3396-3404
1000 acid
FU 15' oil 685' wtr
PB 3390
33/3370-78, 24/3350-58
500 acid
B/20 bw 7 go
3000 acid
TD 3589
9/3583-86
500 acid
S/85 bf 12 hr 85% wtr
D&A

ABANDONED

Kansas

Catherine NW

Map No. _____ Sec. 4 Twp. 13 R. 17W

Well No. 1 Walter

W. L. Hartman Company

_____ Contractor

NW NW SE

E.I. 2056


SECTION PLAT

330 Ft. from N. Line

_____ Ft. from S. Line

_____ Ft. from E. Line

330 Ft. from W. Line

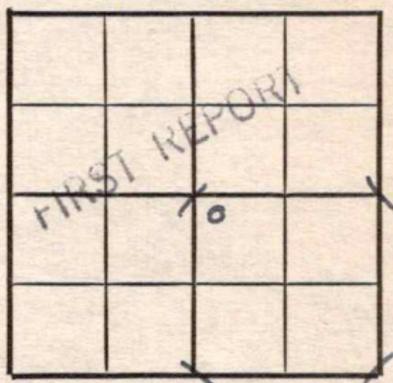

Ellis County

Location _____

Rig up _____

Drilling and Remarks:

R U R

RECORD

Cased _____ in., _____ ft.

Sand _____

Gas _____

Oil _____

Total Depth _____

PRODUCTION

1st 24 hrs. Nat. _____

1st 24 hrs. after shot _____

Gas _____ Cu. Ft.

Dry Hole _____

Abandoned _____

Date

JAN 4 19 _____

J.E. TYRA Scout

Map No. _____ Sec. 4 Twp. 13 R. 17W

Well No. 1 Walter

_____ W. L. Hartman _____ Company

_____ Contractor

NW NW SE

Current plat
measured

E1. 2056

SECTION PLAT

330 Ft. from N. Line

_____ Ft. from S. Line

_____ Ft. from E. Line

375 Ft. from W. Line



Ellis County

Location _____

Rig up _____

Drilling and Remarks:

5" @ 3632

15/ 3480-85

12/ 3500-08

500 acid

B/ 5½ gw 1½ goph

PB 3450

RECORD

Cased _____ in., _____ ft.

Sand _____

Gas _____

Oil _____

Total Depth 3589

PRODUCTION

1st 24 hrs. Nat. _____

1st 24 hrs. after shot _____

Gas _____ Cu. Ft.

Dry Hole _____

Abandoned _____

Date _____

JUL 26 1950 19

J. E. TYRA Scout