

KANSAS


Ellis

FORM 51 5M PETROL

Section 4 Township 13 Range 17W

Well No. 2 Walters

Company Ashland Oil

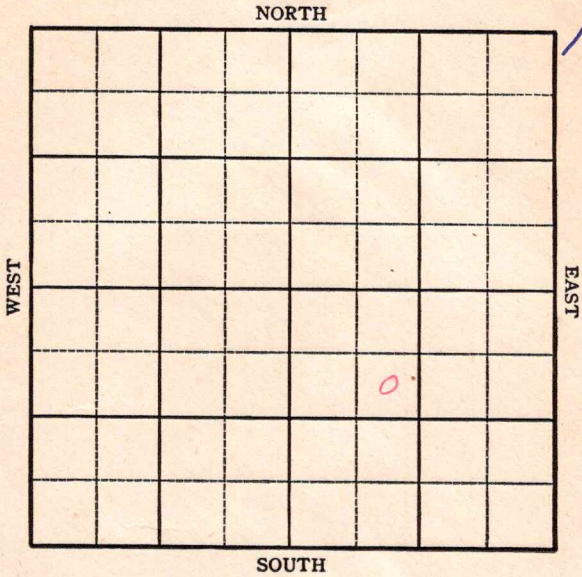

KANSAS

Ellis County

Sec. 4 Twp. 13 R. 17W

Well No. #2 Walters Farm

Ashland Oil Company

Catherine


990 Ft. from N. Line

 Ft. from S. Line

 Ft. from E. Line

990 Ft. from W. Line

SE NW SE

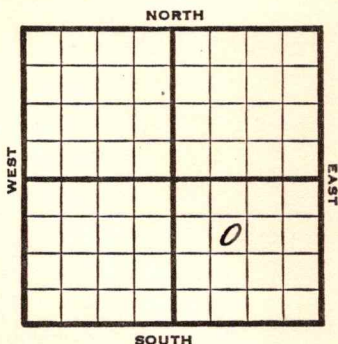

1945

Elev. 2057

REPORT

10/31

Drlg. 405'

11/7

8" @ 1238

Anhy. 1233

Drlg. 2560'

11/14

Cong 3610

3650' in Cong

TD 3650'

ABANDONED

KANSASKansas Pool Name CatherineMap No. 71 Sec. 4 Twp. 13 R. 17WWell No. 2 WaltersAshland Oil

Company

FIRST REPORT

Contractor

SE NW SE

SECTION PLAT990 Ft. from N. Line Ft. from S. Line Ft. from E. Line990 Ft. from W. Line

Ellis CountyLocation Rig up

Drilling and Remarks:

405'**RECORD**Cased in., ft.Sand Gas Oil Total Depth **PRODUCTION**1st 24 hrs. Nat. 1st 24 hrs. after shot Gas Cu. Ft.Dry Hole Abandoned

Date

OCT 3 1 194519S. J. LEWIS

Scout

KANSAS

Kansas

Pool Name CatherineMap No. 71 Sec. 4 Twp. 13 R. 17WWell No. 2 Walters

Ashland Oil

Company

ABANDONED

Contractor

SE NW SE

E12057

SECTION PLAT

990 Ft. from N. Line

Ft. from S. Line

Ft. from E. Line

990 Ft. from W. Line

Ellis County

Location

Rig up

Drilling and Remarks:

Core 3610
3650 in Core

RECORD

Cased _____ in., _____ ft.

Sand _____

Gas _____

Oil _____

Total Depth *3650*

PRODUCTION

1st 24 hrs. Nat. _____

1st 24 hrs. after shot _____

Gas _____ Cu. Ft.

Dry Hole _____

Abandoned _____

Date

NOV 14 1945

19

S. J. LEWIS

Scout