


DX 78-1 Ellis

KANSAS

Section 4 Township 13 Range 17W

Well No. #1 Walters "A"

Company G-M-R Oil

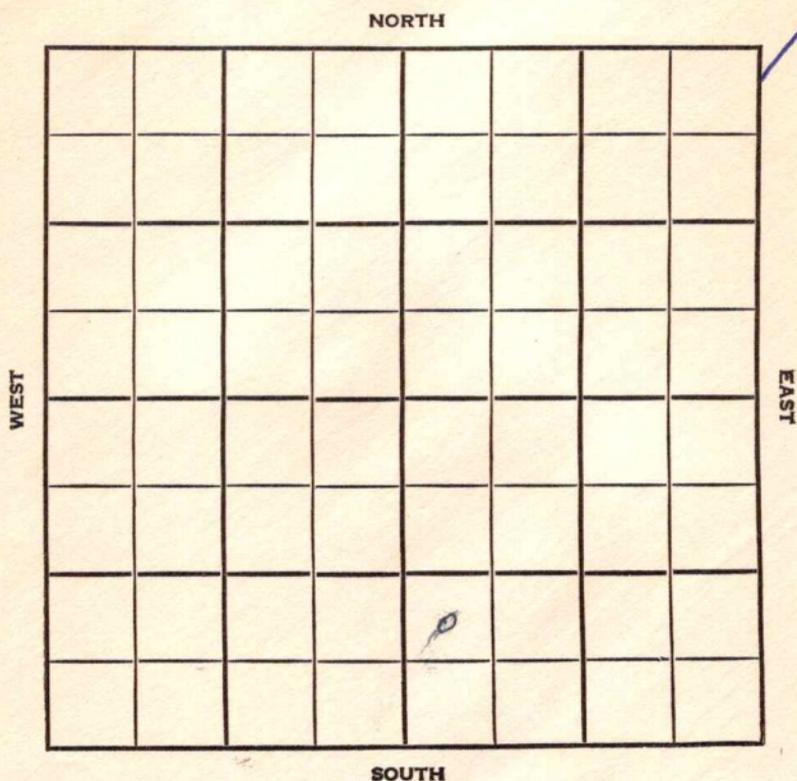

Ellis KANSAS

SEC.	TWP.	R.
4	13	17W

WELL NO. _____
 COMPANY 1 Walters "A" FARM

CONTRACTOR G-M-R Oil


Catherine Pool

_____ Ft. from N. Line

990 _____ Ft. from S. Line

_____ Ft. from E. Line

330 _____ Ft. from W. Line

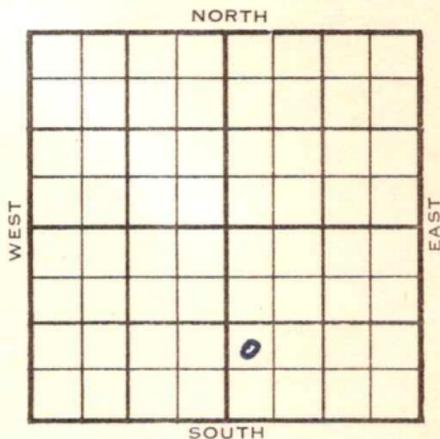

NW SW SE
 Conoco-AC

	ELEVATION	REPORT
1954	2057'	

11/17 Spud 11-15-54
 8" @ 190', WOC

1955
 2/9 Spud 11-15-54
 Oil Well
 TD 3607'
 8" @ 190'
 Heeb 3274' Lans 3320'
 DST 3408'-16' opn 1 hr, rec 340' oil
 1320' gas, 660# Arb. 3572'
 DST 3567'-77' opn 1 hr, rec 12' Mud
 O#
 TD 3577'
 5" @ 3575'
 CO 250 A DD 3599 1 goph 1/ 3591
 1/ 3596 3 goph 750 A DD 3607
 B/ 3 goph 1 bw. B/ 10 go 10 gwph
 SP 3445 16/ 3409-13 2000 A S/ 25
 boph P/ 4 boph
 Comp 25 bopd.

COMPLETED

