


Section 31 Township 17 Range 12-W

Well No. #1 Eveleigh

Company Amerada

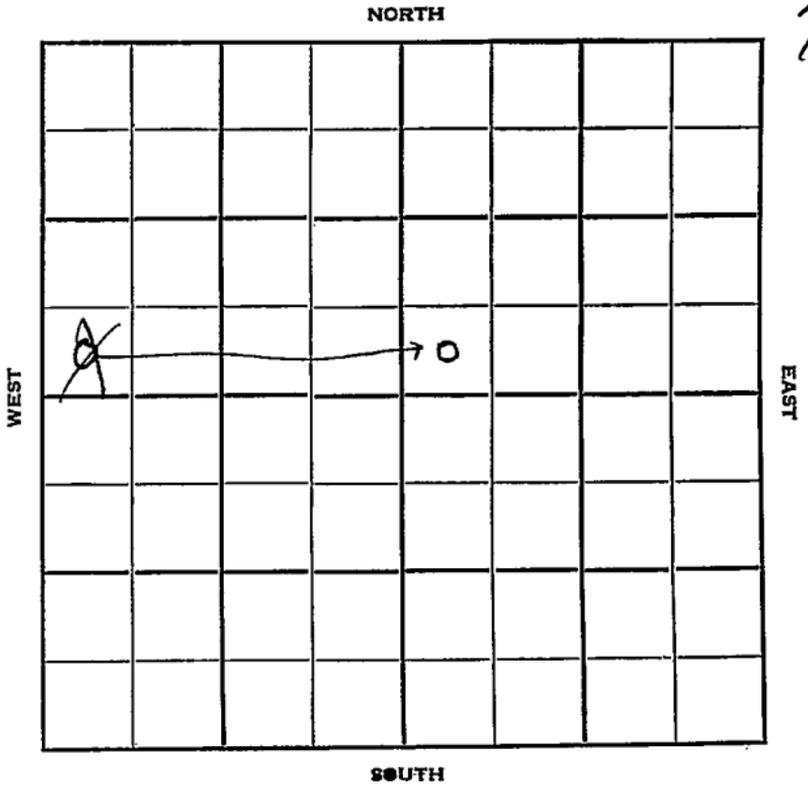

Barton

Sec. 31 Twp. 17 R. 12W

Well No. #1 Eveleigh Farm

Amerada Company

Peel Drlg. Contractor

Red Wing Pool


Ft. from N. Line

330' Ft. from S. Line

Ft. from E. Line

330' Ft. from W. Line

SW SW ^{NE} NW

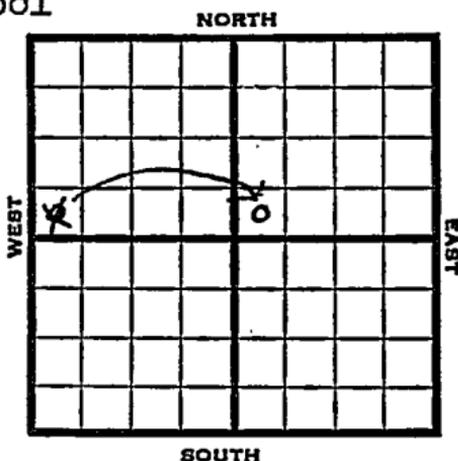

1951 Elev. 1820'

REPORT

1/10 Location

4/4 Spud 1-12-51 Oil well TD 3336'
 8" @ 206' Lans 3081' Arb. 3324-31 TD
 5" @ 3327 B/1/2 BOPH-for 3 hr.
 9/ 3328-31 B/ 18 BO 12 hr. 500 A
 2 1/2 BOPH for 8 hr. 1000 A S/58 BFPD
 2% water DD 3333' S/5 BOPH
 DD 3336' 2000 A 12/ 3324-27
 2000 A S/ 129 BOPD
 Comp. 277 BOPD

COMPLETED

Kansas

Map No. _____ Sec. 31 Twp. 17 R. 12W

Well No. 1 Eveleigh

Amerada Company

CORRECTION Contractor

SW SW NE


SECTION PLAT

_____ Ft. from N. Line

330 Ft. from S. Line

_____ Ft. from E. Line

330 Ft. from W. Line

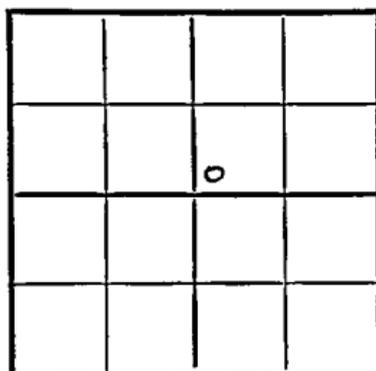

Barton County

Location _____

Rig up _____

Drilling and Remarks:

Reported

SW SW NW

RECORD

Cased _____ in., _____ ft.

Sand _____

Gas _____

Oil _____

Total Depth _____

PRODUCTION

1st 24 hrs. Nat. _____

1st 24 hrs. after shot _____

Gas _____ Cu. Ft.

Dry Hole _____

Abandoned _____

Date

JAN 24 1951 19

J. E. TYRA

Scout

