

KANSAS

Ellis

FORM 51 5M PETROL

Section 4 Township 13 Range 17-W

Well No. #1 Wolf

Company Hartman & Blair

NORTH

			0				

SOUTH

WEST

EAST

3

KANSAS

Ellis

Sec. 4 Twp. 13 R. 17-W

Well No. #1 Wolf Farm

Hartman & Blair Company


990 Ft. from N. Line

 Ft. from S. Line

330 Ft. from E. Line

 Ft. from W. Line

SE NE NW

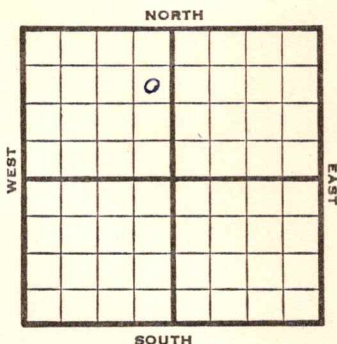

1945 **Elev. 2059'** REPORT

12/12 8" @ 165'
2320'

12/20 **3307.**
Lans ~~3307~~ Drlg. 3490'

12/29 Lans **3307'** (Corrected) BKC 3555'
Arb. 3572-75½' T.D.
5" - 3575½' RUST.

1946
1/10 P.B. to 3496' 48 shots 4483-96'
Swab 5 oil per hour.

1/17 P.B. to 3496' 48 shots 3483-96'
Swab 220 oil in 8 hours.

1/23 **Lans 3307**
Arb. 3572
5" @ 3575½'
Perf. Lans.
TD 3575½'
Pump 134 Pot.
Grav. 33.0

COMPLETED

Kansas Pool Name Madden

KANSAS
 Map No. K-71 Sec. 4 Twp. 13 R. 17W

Well No. 1 Wolf

Hartman & Blair Company

FIRST REPORT

Contractor

SE NE NW

SECTION PLAT

	6		

990 Ft. from N. Line Ft. from S. Line330 Ft. from E. Line Ft. from W. Line

Ellis County

Location Rig up

Drilling and Remarks:

8"-165

2320

RECORD

Cased in., ft.Sand Gas Oil Total Depth

PRODUCTION

1st 24 hrs. Nat. 1st 24 hrs. after shot Gas Cu. Ft.Dry Hole Abandoned

Date

DEC 1 2 1945

19

S. J. LEWIS

Scout


KANSASKansas Pool Name MaddenMap No. 7/ Sec. 4 Twp. 13 R. 17WWell No. 1 WolfHartman & Blair

Company

COMPLETED

Contractor

SE NE NW

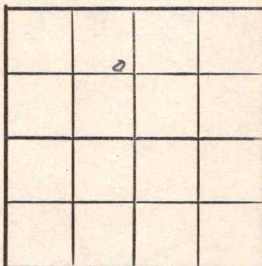E1,2059
SECTION PLAT990 Ft. from N. Line Ft. from S. Line330 Ft. from E. Line Ft. from W. LineEllis CountyLocation Rig up

Drilling and Remarks:

Lane 3307At 35725035 1/2Perf Lane.Sum 1840038-2-2**RECORD**Cased in., ft.Sand Gas Oil Total Depth 3575 1/2**PRODUCTION**1st 24 hrs. Nat. 1st 24 hrs. after shot Gas Cu. Ft.Dry Hole Abandoned

Date

JAN 23 194619S. J. LEWIS

Scout