

KANSAS

Section 4 Township 13 Range 17W

Well No. 4 Welf

Company W. L. Hartman

Catherine
NORTH

WEST

	0						

EAST

SOUTH

24

Ellis **KANSAS**

Sec. 4 Twp. 13 R. 17W

Well No. #4 Wolf Farm

W. L. Hartman Company

Catherine Pool


990' Ft. from N. Line

 Ft. from S. Line

 Ft. from E. Line

990' Ft. from W. Line

SE NW NW

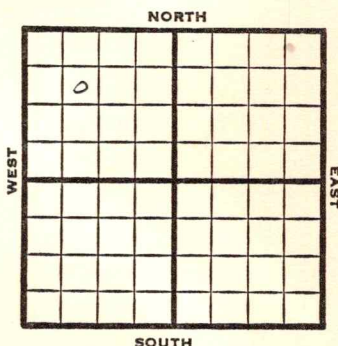

1949

Elev 2074' REPORT

6/8

8" @ 130'

Anhy. 1270'

Drlg. 2805'

6/15

Lansing 3313'

Arb. 3585'

TD 3592'

5" @ 3591'

6/21

"

6/28

"

7/6

TD 3592'

Lans 3313'

Arb. 3585'

5" @ 3591'

Perf Lans 500 acid

Pump 90 Oil Pot

27° Gr.

Comp

COMPLETED

Ellis County Kansas State

Map No. _____ Sec. 4 Twp. 13 R. 17W

Well No. 4 Wolf

W. L. Hartman Company

Contractor

SE NW NW


FIRST REPORT
SECTION PLAT

990 Ft. from N. Line

_____ Ft. from S. Line

_____ Ft. from E. Line


990 Ft. from W. Line

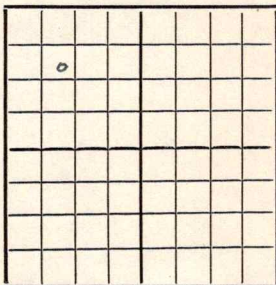

Catherine Pool

Remarks:

8" @ 130 Anny 1270 drlg. 2805

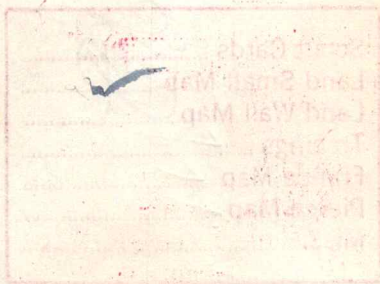

Date JUN 8 1949

Scout S. J. LEWIS

Kansas

Map No. 171 Sec. 4 Twp. 13 R. 17WWell No. 4 Wolf


W. L. Hartman

Company

COMPLETE

Contractor

SE NW NW

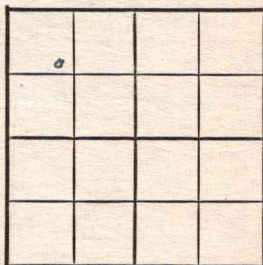E12074
SECTION PLAT990 Ft. from N. Line Ft. from S. Line Ft. from E. Line990 Ft. from W. Line

Ellis County

Location Rig up

Drilling and Remarks:


Date

RECORD

Cased in., ft.Sand Gas Oil Total Depth 3092

PRODUCTION

1st 24 hrs. Nat. 1st 24 hrs. after shot Gas Cu. Ft.Dry Hole Abandoned

JUL 6 1949

19

S. J. LEWIS

Scout