


Section 31 Township 17 Range 12-N

Well No. #1 Eveleigh

Company. Ed Adair

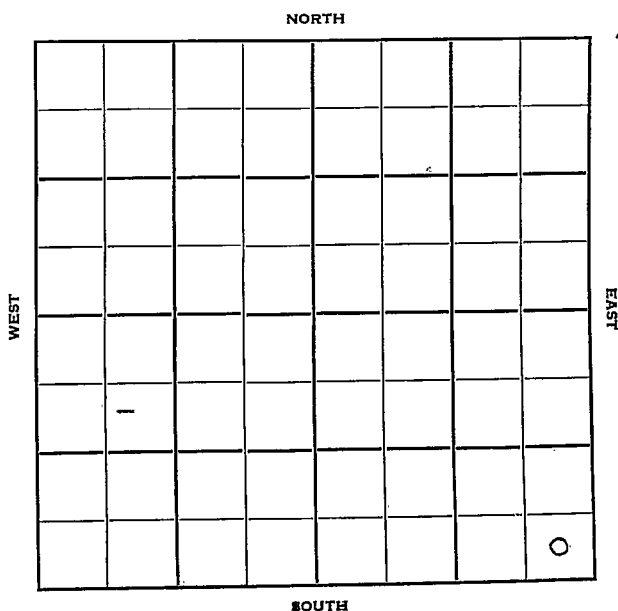

Sec. 31 Twp. 17 R. 12W

Well No. #1 Eveleigh Farm

Ed Adair Company

Adair Contractor
Wildeat

 Ft. from N. Line

330'


 Ft. from S. Line

330'

 Ft. from E. Line

 Ft. from W. Line

SE SE SE

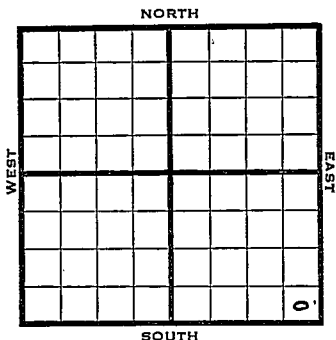

1950

Elev 1813

REPORT

8/9

MIM

11/1

Spud 8-13-50

8 5/8" @ 198

Anhy 705

Heeb 3984

Lans 3086

DST 3217-33 opn 1/2 hr rec 35' socm

Arb 3335-40

DST 3336-40 opn 20 min rec 20' socm

5" @ 3336-40

TD 3343

FU 1100' oil over nite

1000 A


S/4 boph

Comp 108 bopd

Completed

COMPLETED

J. E. TYRA

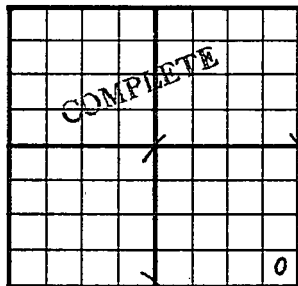County Barton State KansasSec. 31 (Blk.) 17 (Sur.) 12W Map No.Operator Ed AdairWell No. 1 Farm EveleighElev. 1813 Location SE SE SE330 Ft. From S Line SE330 Ft. From E Line Quarter1st. ReportCompletion NOV 1 1950Remarks WildcatAdair - Contr.Spudding Date 8-13-50Drlg. Data Oil well TD 33438 5/8" @ 198 Anhy 705 Heeb. 2984Lans. 3086 DST 3217-33 open 1/2 hr.Rec. 35' socm Arb. 3335-40 DST 3336-40open 20 min. Rec. 20' socm 5" @ 3336TD 3343 FU 1100' oil over nite 1000 AS/ 4 boph Comp. 108 bopd

J. E. TYRA