



Map No. **KANSAS** Sec. 31 Twp. 12 R. 15<sup>w</sup>


Well No. 1-Jacobs Farm  
Texas Oil Company

\_\_\_\_\_ Ft. from N. Line

330 Ft. from S. Line

\_\_\_\_\_ Ft. from E. Line

330 Ft. from W. Line

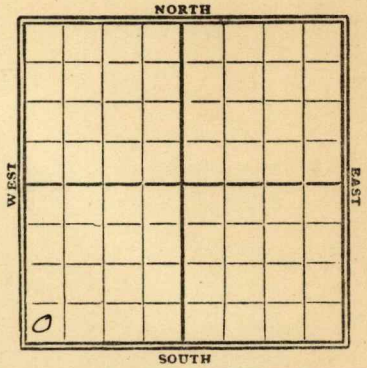

1929

Date REPORT

| Date        | REPORT  |
|-------------|---|
| <u>3/6</u>  | <u>Location</u>   |
| <u>3/13</u> |   |
| <u>3/20</u> | <u>Bldg Rqy</u>   |
| <u>3/27</u> | <u>Rgn up</u>   |
| <u>4/3</u>  |   |
| <u>4/10</u> | <u>—</u>  |
| <u>4/17</u> | <u>Spud 315'</u>  |
| <u>4/24</u> | <u>Drlg 475'</u>  |
| <u>5/1</u>  | <u>" 840'</u>   |
| <u>5/8</u>  | <u>" 1525</u>   |
| <u>5/14</u> | <u>" 2250'</u>  |
| <u>5/22</u> | <u>" 2470</u>   |
| <u>5/29</u> | <u>nrly 2750 show oil 2705</u>  |
| <u>6/5</u>  | <u>T.D. 2750. J.D.</u>  |
| <u>6/12</u> | <u>HFW 3214 T.D. 3216</u><br><u>L.R. 6"</u>   |
| <u>6/19</u> | <u>—</u>  |
| <u>6/26</u> | <u>—</u>  |
| <u>7/2</u>  | <u>—</u>  |
| <u>7/9</u>  | <u>show oil 2900'</u><br><u>Pay 2983-89-</u><br><u>600' oil in hole 1 hr.</u><br><u>T.D. 3007 - 2000' oil</u> |

7/17- Pay 2983-89

T.D. 3007'

Pump 60 bbl oil

Comp.

1931

OWDD

10/7- Old T.D. 3007

Regn up

10/14- T.D. 3030' fishing

10/21- Increase 3068-75

T.D. 3075

swab 240 bbl oil

Comp.

*Russell*

MAP NO. **KANSAS** SEC. 31 TWP. 12 R. 15W

WELL NO. 1 Jacobs

Texas Oil COMPANY

CONTRACTOR

**SECTION PLAT**

|  |  |  |  |
|--|--|--|--|
|  |  |  |  |
|  |  |  |  |
|  |  |  |  |
|  |  |  |  |

\_\_\_\_\_ FT. FROM N. LINE

330 FT. FROM S. LINE

\_\_\_\_\_ FT. FROM E. LINE

330 FT. FROM W. LINE

**FIRST REPORTS**

LOCATION ✓

RIG UP \_\_\_\_\_

DRILLING AND REMARKS:

**RECORD**

CASED \_\_\_\_\_ IN. \_\_\_\_\_ FT.

SAND \_\_\_\_\_

GAS \_\_\_\_\_

OIL \_\_\_\_\_

TOTAL DEPTH \_\_\_\_\_

**PRODUCTION**

1ST 24 HRS. NAT. \_\_\_\_\_

1ST 24 HRS. AFTER SHOT \_\_\_\_\_

GAS \_\_\_\_\_ CU. FT.

DRY HOLE \_\_\_\_\_

ABANDONED \_\_\_\_\_

DATE

**MAR 6 1929** 192

**S. J. LEWIS**

SCOUT

*Russell*

Map No. **KANSAS** Sec. *31* Twp. *12* R. *15W*

Well No. *72 Jacobs*

*Texas Oil* Company

Contractor

**SECTION PLAT**

..... Ft. from N. Line

*330* Ft. from S. Line

..... Ft. from E. Line

*330* Ft. from W. Line

|  |  |  |  |
|--|--|--|--|
|  |  |  |  |
|  |  |  |  |
|  |  |  |  |
|  |  |  |  |
|  |  |  |  |

**COMPLETED**

Location.....

Rig up.....

Drilling and Remarks:

*Pay 2983-89*

*Pump 60 886*

**RECORD**

Cased..... in., ..... ft.

Sand.....

Gas.....

Oil.....

Total Depth *3007*

**PRODUCTION**

1st 24 hrs. Nat.....

1st 24 hrs. after shot.....

Gas..... Cu. Ft.

Dry Hole.....

Abandoned.....

Date

**JUL 17 1929**

**S. J. LEWIS**

192

Scout

*Kussell*

72 **KANSAS** Sec. *31* Twp. *12* R. *15*<sup>W</sup>

Well No. *1* *Jacobs*

*Texas Co* Company

Contractor

**FIRST REPORTS**  
~~FIRST REPORTS~~

**SECTION PLAT**

|  |  |  |  |
|--|--|--|--|
|  |  |  |  |
|  |  |  |  |
|  |  |  |  |
|  |  |  |  |
|  |  |  |  |

..... Ft. from N. Line

*330* Ft. from S. Line

..... Ft. from E. Line

*330* Ft. from W. Line

" *OWOOD* "

Location.....

Rig up *old JD 3007*

Drilling and Remarks:

*Rigging up.*

**RECORD**

Cased..... in., ..... ft.

Sand.....

Gas.....

Oil.....

Total Depth.....

**PRODUCTION**

1st 24 hrs. Nat.....

1st 24 hrs. after shot.....

Gas..... Cu. Ft.

Dry Hole.....

Abandoned.....

Date

**OCT 7 1931**

192 **CHAS. L. SHERWOOD** Scout

Russell

72 **KANSAS** Map No. Sec. 31 Twp. 12 R. 15<sup>W</sup>

Well No. 1 Jacobs  
Texas Co Company

Contractor

**COMPLETED**

**SECTION PLAT**

..... Ft. from N. Line

330 Ft. from S. Line

..... Ft. from E. Line

330 Ft. from W. Line

|   |  |      |  |
|---|--|------|--|
|   |  |      |  |
|   |  |      |  |
|   |  |      |  |
|   |  |      |  |
| 0 |  | DWDD |  |

Location.....

Rig up.....

Drilling and Remarks:

increase 3068-75

Swab 240 Bks.

**RECORD**

Cased..... in., ..... ft.

Sand.....

Gas.....

Oil.....

Total Depth 2075

**PRODUCTION**

1st 24 hrs. Nat.....

1st 24 hrs. after shot.....

Gas..... Cu. Ft.

Dry Hole.....

Abandoned.....

Date

OCT 21 1931

192.....

**CHAS. L. SHERWOOD**

Scout