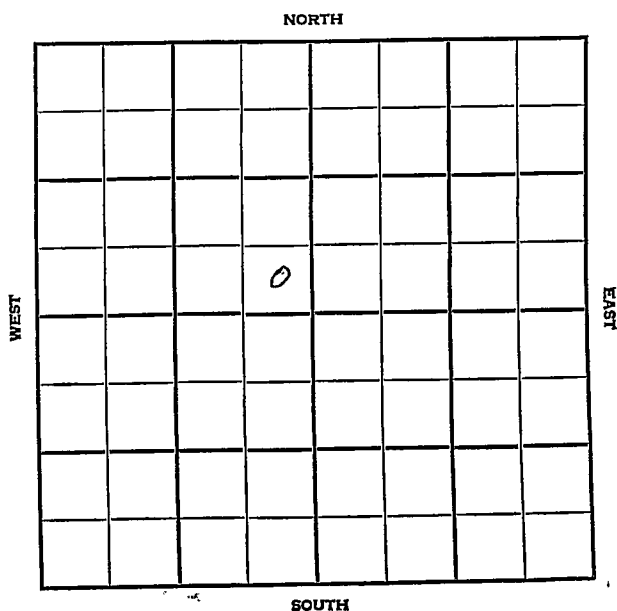


Section 32 Township 17 Range 12 WWell No. #1 SteinerCompany Bennett & Roberts

Barton

KANSAS

SEC.	TWP.	R.
32 -	17	12W

WELL NO.

#1 Steiner

FARM

COMPANY

Bennett & Roberts

CONTRACTOR

Co. Tools

E. Redwing


Ft. from N. Line

Ft. from S. Line

Ft. from E. Line

Ft. from W. Line

SE SE NW

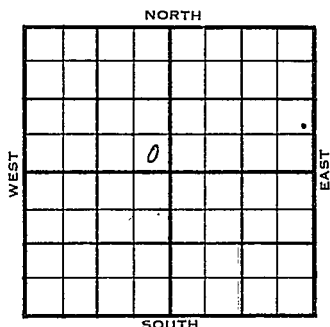

1956

ELEVATION

1827'

REPORT

2-22

Comm. 2-20-56
Drlg. 500

5-16

8 5/8" @ 500
 DST 3107-40 op 1 hr. rec. 60' o&wcm,
 400#.
 DST 3144-60 op 1 hr. rec. 30' wm, 0#.
 5 1/2" @ 3350/75
 CO 3355
 B/ 3 gwph, 9/ 3351-54, 1000 A,
 S/ 5 boph,
 P/ 25 bopd, 75% wtr.
 Comp. 30 bopd, 45% wtr.
 H. 2988', Tr. 3010', BL. 3085',
 L. 3100', A. 3349'.
 TD 3355'

COMPLETED

County

~~Barton~~

Elev.

Sec.

32

Twp.

~~17~~

Rge.

12W

Company

~~Bennett & Roberts~~

FarmName

Steiner

No.

1

TOPS

DEPTH

LOG

DATUM

Loc. in Sec.

SE SE NW

Anb.

Tp.

H.

Tr.

Dg.

Bl.

L.

K.C.

B.K.C.

Ce.

C.

M.

M.

K.

Mz.

Mq.

V.

S.

S.

A.

R.

PE.

G.

T.D.

Geol.

Contr.

Co. tools

Pool

E. Redwing

FEB 22 1956

FIRST REPORT

Date Comm.

2-20-56

drlg. 500

Co.

Use.

No.

Sec.

T.

R.

County Barton Elev. 1827Sec. 32 Twp. 17 Rge. 12WCompany Bennett & RobertsFarm Name Steiner No. 1

TOPS	DEPTH	LOG	DATUM	Loc. in Sec.
Anh.				SE SE NW
Tr.				
H.	<u>2988</u>			
Tr.	<u>3010</u>			
Dg.				
BL.	<u>3085</u>			
L.	<u>3100</u>		<u>1273</u>	Geol.
K.C.				Contr.
B.K.C.				Co. tools
Ce.				Pool
C.				E. Redwing
M.				
M.				
K.				
Mz.				
Ma.				
V.				
S.				
S.				
A.	<u>3349</u>		<u>1522</u>	COMPLETE
R.				
Pe.				
G.				
TD.	<u>3355</u>			

Date Comm. 2-20-56 MAY 16 19568 5/8" @ 500 DST 3107-40 open 1 hr.rec. 60' o & wcm 400# DST 3144-60open 1 hr. rec. 30' wcm 0#5 1/2" @ 3350/75 CO 3355 B/ 3 gwph9/ 3351-54 1000 A S/ 5 bophP/ 25 bopd 75% wtr.Comp. 30 bopd 45% wtr.