

Section 4 Township 13 Range 17 W

Well No. # 5 Wolf

Company ~~W. L. Hartman~~ Texas Co.

NORTH

WEST

EAST

		0					

SOUTH

3

Ellis

**KANSAS**

Sec. 4 Twp. 13 R. 17W

Well No. #5 Wolf Farm  
TEXAS CO.  
W. L. Hartman Company

Contractor

Catherine Pool


990' Ft. from N. Line

Ft. from S. Line

990' Ft. from E. Line

Ft. from W. Line

SW NE NW

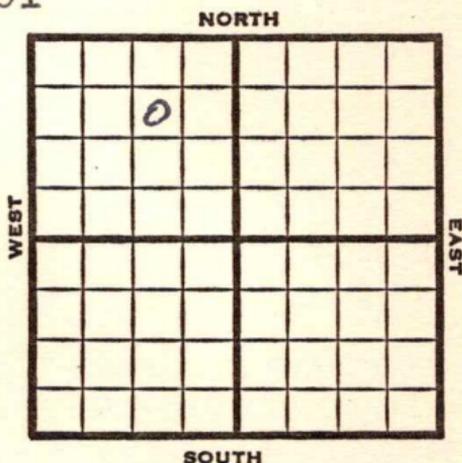

1951 **Elev 2076'** REPORT

9/19 Cellar & Pits

1952  
2/6 P. 62 B0 & 20 BOPD

2/13 No report

2/20 Spud 9-30-51  
Oil Well TD 3599  
8" @173

**Top 3037** DST 3255-71 opn 1 hr.

Rec. 30' mud **Heeb. 3292**

**Dodge 3312**

DST 3315-22 opn 1 hr Rec. 300'

wtr **Arb. 3589** TD 3599

5" @ 3589 @ to 3599 P/3 bo 12 Bw

Comp. 38 bopd 7 bw

**COMPLETED**

County Ellis State Kansas

Sec. 4 (Blk. 13) (Sur. 17W) (Twp.) (Rge.) Map No.

Operator W. L. Hartman

Well No. 5 Farm Wolf

Elev. Location SW NE NW

	0				

990 Ft. From N Line NW

990 Ft. From E Line Quarter

1st. Report SEP 19 1951

Completion

Remarks

Spudding Date

Drlg. Data Cathrine - pool

Cellar & pits

Kansas

Map No. \_\_\_\_\_ Sec. 4 Twp. 13 R. 17W

Well No. 5 Wolf

Texas Company Company

CORRECTION Contractor

SW NE NW


SECTION PLAT

990 Ft. from N. Line

\_\_\_\_\_ Ft. from S. Line

990 Ft. from E. Line

\_\_\_\_\_ Ft. from W. Line

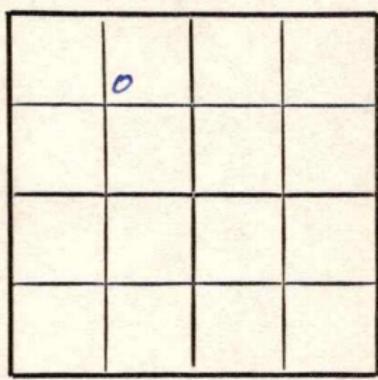

Ellis County

Location \_\_\_\_\_

Rig up \_\_\_\_\_

Drilling and Remarks:

Reported

W. L. Hartman

RECORD

Cased \_\_\_\_\_ in., \_\_\_\_\_ ft.

Sand \_\_\_\_\_

Gas \_\_\_\_\_

Oil \_\_\_\_\_

Total Depth \_\_\_\_\_

PRODUCTION

1st 24 hrs. Nat. \_\_\_\_\_

1st 24 hrs. after shot \_\_\_\_\_

Gas \_\_\_\_\_ Cu. Ft.

Dry Hole \_\_\_\_\_

Abandoned \_\_\_\_\_

Date

DEC 5 1951 19 \_\_\_\_\_

J. E. TYRA

Scout

REC-10-1951

