


Section 31 Township 12 Range 15-W

Well No. #8 Jacobs SWD

Company Texas

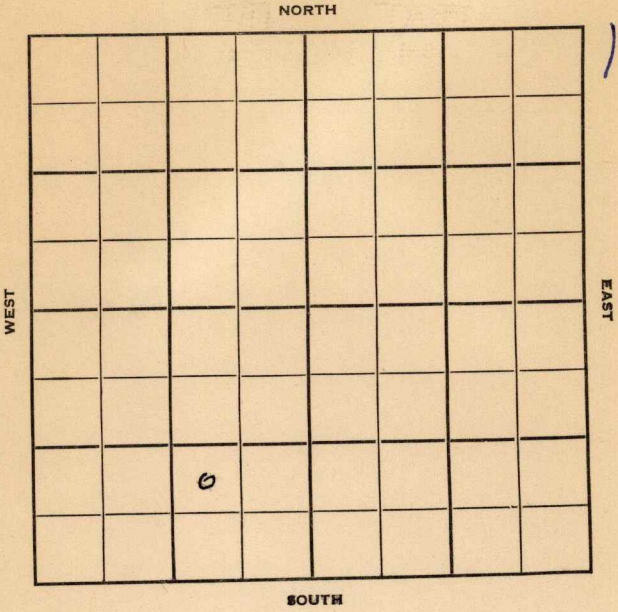

Sec. 31 Twp. 12 R. 15-W

Well No. #8 Jacobs SWD Farm

Texas Company


Stearns Drlg. Contractor

\_\_\_\_\_ Ft. from N. Line

990 Ft. from S. Line

990 Ft. from E. Line

\_\_\_\_\_ Ft. from W. Line

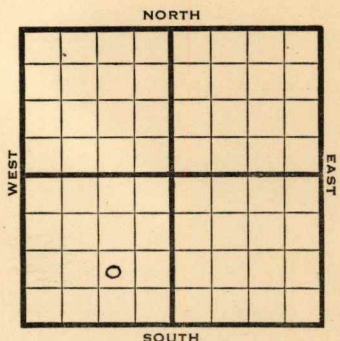

NW SE SW

1950 **Elev 1841** REPORT

7/12 Spud 7-5-50  
10 3/4" @ 908  
Drlg 1950

8/23 10 3/4" @ 908

**Top 2603**

**Dol 2949**

**Lans 2983**

**Arb 3271**

TD 3486

7" @ 3318

**Granite 3478**

Comp for SWD

Completed

**COMPLETED**

Kansas

Map No. \_\_\_\_\_ Sec. 31 Twp. 12 R. 15W

Well No. 8 Jacobs SWD

\_\_\_\_\_ Texas \_\_\_\_\_ Company

\_\_\_\_\_ Stearns Drlg. \_\_\_\_\_ Contractor

NW SE SW

*E1-1841*  
SECTION PLAT

\_\_\_\_\_ Ft. from N. Line

990 Ft. from S. Line

990 Ft. from E. Line

\_\_\_\_\_ Ft. from W. Line

	0		

FIRST REPORT

Russell County

Location \_\_\_\_\_

Rig up \_\_\_\_\_

Drilling and Remarks:

Spud 7-5-50

10 3/4" © 908

drlg. 1950

RECORD

Cased \_\_\_\_\_ in., \_\_\_\_\_ ft.

Sand \_\_\_\_\_

Gas \_\_\_\_\_

Oil \_\_\_\_\_

Total Depth \_\_\_\_\_

PRODUCTION

1st 24 hrs. Nat. \_\_\_\_\_

1st 24 hrs. after shot \_\_\_\_\_

Gas \_\_\_\_\_ Cu. Ft.

Dry Hole \_\_\_\_\_

Abandoned \_\_\_\_\_

Date

JUL 12 1950 19

J. E. TYRA Scout

