


Section Ellis
4 Township 13 Range 17W
Well No. 6 Wolf
Company Texas Company

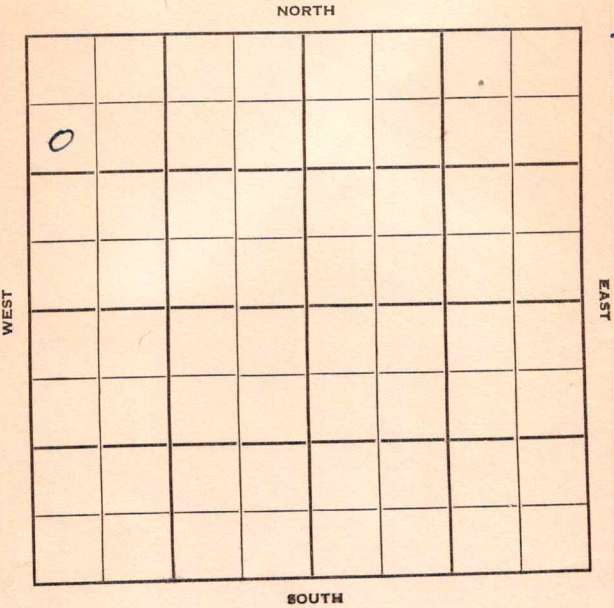

E^{llis}

KANSAS

Sec. 4 Twp. 13 R. 17WWell No. #6Wolf Farm

Texas Company Company

Contractor


990 Ft. from N. Line

Ft. from S. Line

Ft. from E. Line

330 Ft. from W. Line

SW NW NW

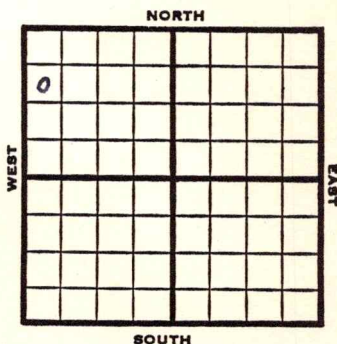

1953

Elev. 2073

REPORT

1/14

Location

1/22

"

1/29

10" @ 1278

Drlg. 2830'

2/5

Tor 3293'

DST 3294-3318' 1 hr, 450' oil 1075#

Lans. 3321' Arb. 3583'

RTD 3590' 7" @ 3584'

2/12

CO 3590' 1 GMPH 500 A DD 3597'

34 GO plus 1 GWPH 6 hrs.

2/18

Spudding Date 1/17/53

Oil Well TD 3597

10" @ 1278 Tor. 3293 DST 3294-

3318 open 1 hr. Rec. 450'

oil 1075# Lans. 3321 Arb. 3583

TD 3590 7" @ 3584 CO to 3590 1

gmph 500 A DD 3597 34 go

1 gwph 6 hr. 500 A

S/7 boph Comp. 342 bopd

COMPLETED

County Ellis State Kansas
 Sec. 4 (Blk. 13) (Sur. 17W) Map No.

Operator Texas Company

Well No. 6 Farm Wolf

Elev. Location SW NW NW

0							

990 Ft. From N Line NW

330 Ft. From W Line Quarter

1st. Report JAN 14 1953

Completion

Remarks

Spudding Date

Drlg. Data

Location

County Ellis State KansasSec. 4 (Blk.) 13 (Sur.) 17W Map No.Operator Texas CompanyWell No. 6 Farm WolfElev. 2073 Location SW NW NW

0							

990 Ft. From N Line NW330 Ft. From W Line Quarter

1st. Report

Completion FEB 18 1953

Remarks

Spudding Date 1-17-53Drlg. Data Oil well TD 359710" @ 1278 Tor. 3293 DST 3294-3318open 1 hr. Rec. 450' oil 1075#Lans. 3321 Arb. 3583 TD 35907" @ 3584 CO to 3590 1 gmph 500 ADD 3597 34 go 1 gwph 6 hr. 500 AS/ 7 boph Comp. 342 bopd

J. G. McGEHEE