


Section 31 Township 12 Range 15W

Well No. ⁸~~#6~~ P. Jacobs

Company Texas Company

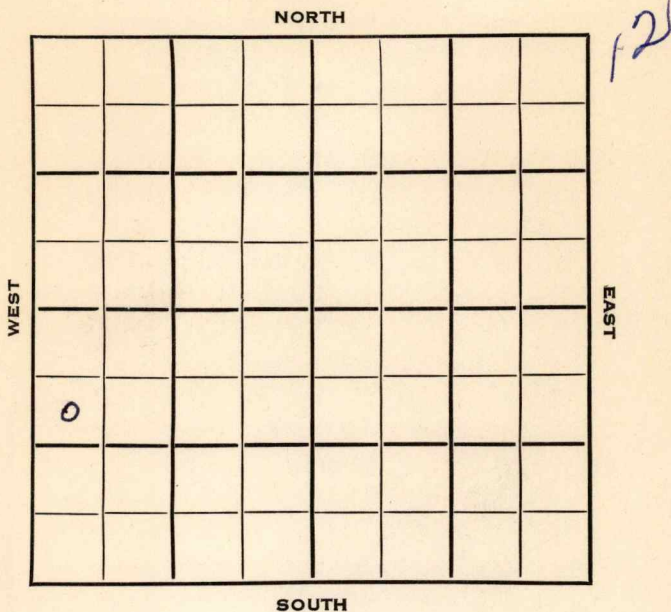

Russell

KANSAS

Sec. 31 Twp. 12 R. 15WWell No. #6 P. Jacobs Farm

Texas Company Company

Contractor

948 Fairport Pool990 Ft. from N. Line


Ft. from S. Line

Ft. from E. Line

371330

Ft. from W. Line

SW NW SW (TWIN)

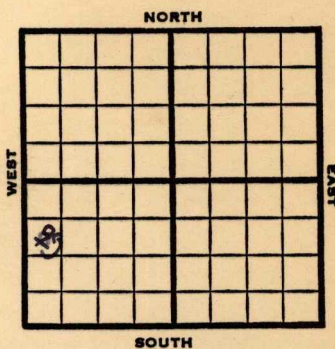

1953

Elev. 1869' REPORT

9/2

Location

9/9

10" @ 935'
Drlg. 2000'

9/16

Top 2726' Heeb 2934' Lans 2985'
Arb. 3268' - Drlg.

9/23

NR

9/30

Spud 9-4-53 Oil well TD 3276
 10" @ 935' Top 2726 Heeb 2934
 Lans 2985 Arb. 3268
 TD 3275 7" @ 3273 DD 3276
 S/1/2 BOPH 6 hr. 500 A S/15 1/2 BO
 6 BWPH 9 hr.
 Comp. 80 BOPD 120 BW

COMPLETED

County **Russell** State **Kansas**

Sec. **31** (Blk. **12** (Sur. **15W** Map No.

Operator **Texas Company**

Well No. 6 Farm P. Jacobs

Elev.	Location	SW	NW	SW	(twin)
-------	----------	----	----	----	--------

990 Ft. From N Line SW

330 Ft. From W Line Quarter

1st. Report SEP 2 1953

Completion

Remarks

Spudding Date _____

Drig. Data Fairport Pool

Location

J. G. McGEHEE

Map No. _____ Sec. 31 Twp. 12 R. 15WWell No. 8 P. Jacobs_____
Texas Company Company

CORRECTION

Contractor

SW NW SW

SECTION PLAT

948 Ft. from N. Line_____
Ft. from S. Line_____
Ft. from E. Line371 Ft. from W. Line

Russell County

Location _____

Rig up _____

Drilling and Remarks:

Reported
#6 Jacobscorrect
P. Jacobs
SB

RECORD

Cased _____ in., _____ ft.

Sand _____

Gas _____

Oil _____

Total Depth _____

PRODUCTION

1st 24 hrs. Nat. _____

1st 24 hrs. after shot _____

Gas _____ Cu. Ft.

Dry Hole _____

Abandoned _____

Date

SEP

9 1953

19

J. G. McGEHEE

Scout

