

KANSAS

Ellis county

Section 4 Township 13 Range 17W

Well No. #2, Wolf "A"

Company Hartman & Blair

NORTH

			O				

SOUTH

WEST

EAST

3

KANSAS

Ellis County

Sec. 4 Twp. 13 R. 17W

Well No. #2 Wolf "A" Farm

Hartman & Blair Company

Catherine


330 Ft. from N. Line

 Ft. from S. Line

330 Ft. from E. Line

 Ft. from W. Line

NE NW

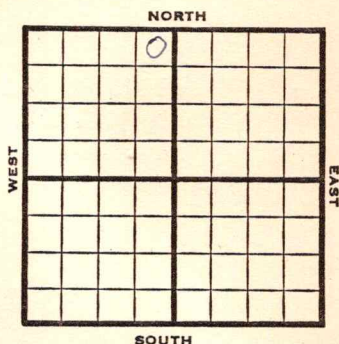

1946

Elev. 2071

REPORT

4/17 8" @ 195

Drlg. 210'

4/23 Lans 3316

Drlg 3414 30

4/30 Aro 3575-77

TD 5" @ 3575 RUST

5/7 " " "

5/14 " " "

5/21 " " "

5/29 " " "

6/5 " " "

6/12 " " "

6/18 " " "

6/26 TD 3582'

Swb 2½ oil in 1 hr

7/3 3000 acid

Swb 6 oil PH

7/9 Swb 12½ oil PH 8 hrs

7/16 " "

7/23 " "

7/30 " "

8/6 Pump 25 oil

8/13 "

8/20 "

8/27 "

OVER

719517

1946

9/5

Arb 3575

5" @ 3575

TD 3582

Acid 3000 gal

Pump 697 oil plus 2% w POT

Grav. 26

COMPLETED

Kansas Pool Name Catherine

KANSAS
 Map No. 71 Sec. 4 Twp. 13 R. 17W

Well No. 2 Wolf "A"
Hartman & Blair Company

FIRST REPORT Contractor

NE NW

SECTION PLAT

330 Ft. from N. Line Ft. from S. Line330 Ft. from E. Line Ft. from W. Line

		0	

Ellis CountyLocation Rig up

Drilling and Remarks:

8" @ 195

Drlg. 210

RECORD

Cased in., ft.Sand Gas Oil Total Depth

PRODUCTION

1st 24 hrs. Nat. 1st 24 hrs. after shot Gas Cu. Ft.Dry Hole Abandoned Date
APR 17 1946 19 S. J. LEWIS Scout

KANSAS

Kansas

Pool Name CatherineMap No. 71 Sec. 4 Twp. 13 R. 17WWell No. 2 Wolf "A"Hartman & Blair

Company

COMPLETED

Contractor


NE NW

E1.2071
SECTION PLAT330 Ft. from N. Line

Ft. from S. Line

330 Ft. from E. Line

Ft. from W. Line

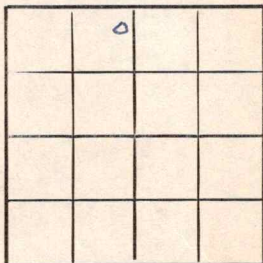Ellis County

Location

Rig up

Drilling and Remarks:


Cased _____ in., _____ ft.

Sand _____

Gas _____

Oil _____

Total Depth 2575**PRODUCTION**

1st 24 hrs. Nat. _____

1st 24 hrs. after shot _____

Gas _____ Cu. Ft.

Dry Hole _____

Abandoned _____

Date

SEP 5 1946

19

S. J. LEWIS

Scout