


Barton

KANSAS

SECTION 32 TOWNSHIP 17S RANGE 12W

WELL NO. #4 Hoeffner

COMPANY Bennett & Roberts

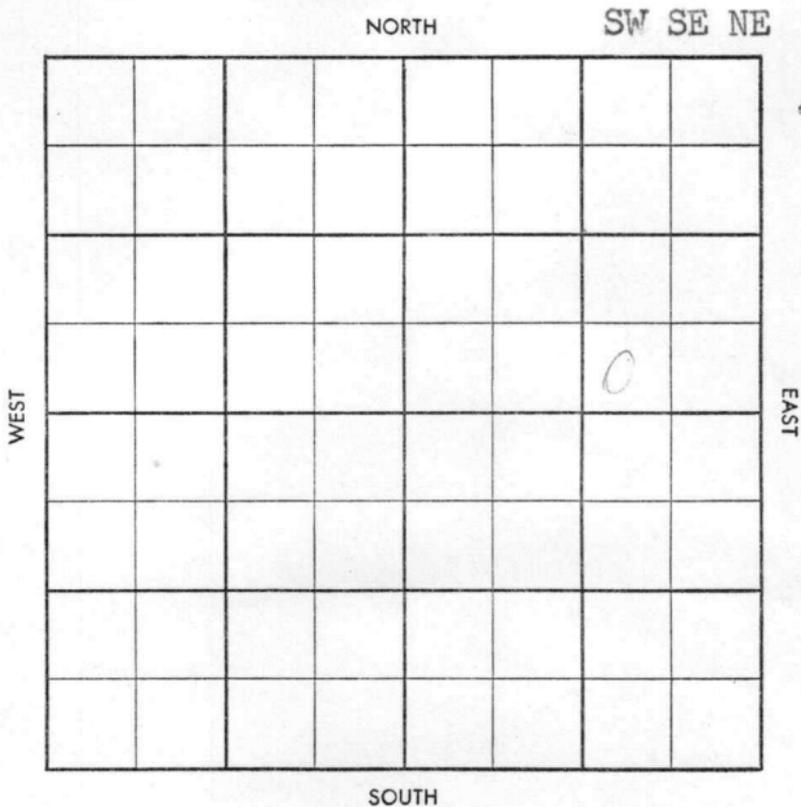

Twp. ~~_____~~ Pool ~~_____~~
 Co. ~~_____~~ Facet ~~_____~~

S-513-B

County Barton Elev. _____
 Sec. 32 Twp. 17 Rge. 12W
 Company Bennett & Roberts
 Farm Name Hoeffoner No. 4

TOPS	DEPTH	LOG	DATUM
Anh. _____	<u>712</u>		
Tp. _____			
H. _____			
Tr. _____			
Dg. _____			
B.L. _____			
L. _____			
K.C. _____			
B.K.C. _____			
Ce. _____			
C. _____			
M. _____			
M. _____			
K. _____			
Mz. _____			
Mq. _____			
V. _____			
S. _____			
S. _____			
A. _____			
R. _____			
Pf. _____			
G. _____			
T.D. _____			

Loc. in Sec. _____
SW SE NE
 Geol. J. Chase
 Contr. _____
Co. Tools #1
 Pool _____
Redwing E.

JUN 11 58
FIRST REPORT

Date Comm. 6-6-58
3" @ 719 w/300, Drlg. 2760

Co.
Lse.
No.
Sec.
T.
R.

No

Twp. 45S Pool

Co. Facet

13

S-513-B

County Barton Elev. 13350 13298

Sec. 32 Twp. 17 Rge. 1825 12W

Company Bennett & Roberts

Farm Name Hoeffner No. 4

TOPS	DEPTH	LOG	DATUM
Anh.	712		
Tp.	2203		
H.	2987		
Tr.	3006		
Dg.	3018		
B.L.	3082		
L.	3100		
K.C.			
B.K.C.			
Ce.			
C.	3337		
M.			
M.			
K.			
Mz.			
Mq.			
V.			
S.			
S.			
A.	3352		
R.			
Pf.			
G.			
T.D.	3383	3383	

Loc. in Sec. SW SE NE

Geol. J. Chase

Contr.

Co. Tools # 1

Pool Redwing E.

COMPLETE

0

SEP 3 '58

Date Comm. 6-6-58

8" @ 719 w/300, Drlg. 2760 JUN 18 '58 DST

3127-50 60" 25' M rainbow 13HP

O DST 3152-92 1hr 200gip 60'

fuggy oil 128' 400gum BHP 515/20

5" 3378 JUN 25 '58 CO JUL 2 '58 DD 3385

TD B 5600 26 gwm ph NT A

\$ 16 B F Ph 8.6 oil NT PB 3200

17/3180-83 A \$ 4890 + 20g wph

A \$ 6390 + 33g wph PB 3175

Co. Lse. No. Sec. T. R.

25/3168-72 \$ 6090 + 13gw
 ph A \$ 4790 + 56gw ph
 CO 3190 \$ 5650 87gw ph
 topop

JUL 9 '58

JUL 16 '58

JUL 23 '58

JUL 30 '58

AUG 6 '58

AUG 13 '58

AUG 20 '58

AUG 27 '58

SEP 3 '58

P 25 B opd + 1090w

32-17-12w

sw se ne

ET 1825
TD 1558
PB 1350
5" 1553
P# 1343 - 1347