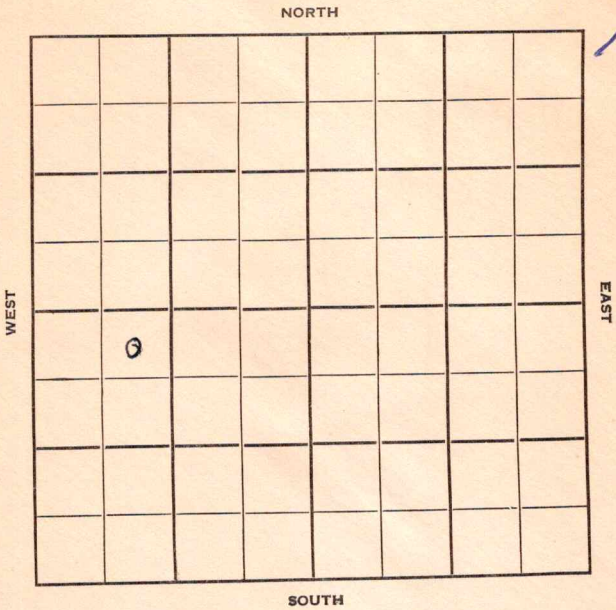


FORM 51 25M 3-49 PETROL

Section 4 Township 13 Range 17WWell No. #2 Wolf "B"Company W. L. Hartman

Ellis

KANSAS

Sec. 4 Twp. 13 R. 17W

Well No. #2 Wolf "B" Farm

W. L. Hartman

Catherine Pool (Hartman, Contr.) Company


330' Ft. from N. Line

Ft. from S. Line

Ft. from E. Line

990' Ft. from W. Line

NE NW SW

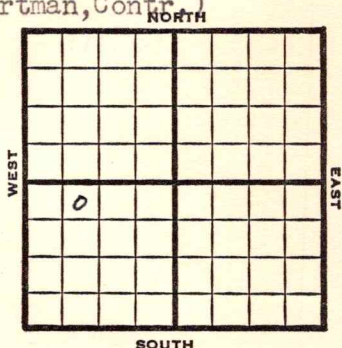

1949

Elev. 2055' REPORT

12/28

Location

1950

1/25

8" @ 125'

Anhy 1251'

Topeka 3048'

Heeb 3301'

Lans 3347'

Congl 3595'

Simpson 3677'

Arb 3683'

No shows

TD 3687'

D&A

ABANDONED

Map No. _____ Sec. 4 Twp. 13 R. 17W

Well No. 2 Wolf "B"

W. L. Hartman Company

Hartman Contractor

NE NW SW


**FIRST REPORT
SECTION PLAT**

330 Ft. from N. Line

_____ Ft. from S. Line

_____ Ft. from E. Line

990 Ft. from W. Line

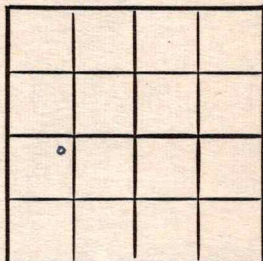

Ellis County

Location X

Rig up _____

Drilling and Remarks:

RECORD

Cased _____ in., _____ ft.

Sand _____

Gas _____

Oil _____

Total Depth _____

PRODUCTION

1st 24 hrs. Nat. _____

1st 24 hrs. after shot _____

Gas _____ Cu. Ft.

Dry Hole _____

Abandoned _____

Date

DEC 28 1949 19

S. J. LEWIS Scout

Map No. _____ Sec. 4 Twp. 13 R. 17WWell No. 2 Wolf "B"

W. L. Hartman _____ Company

Contractor

NE NW SW

E1, 2055
SECTION PLAT

330 Ft. from N. Line

_____ Ft. from S. Line

_____ Ft. from E. Line

990 Ft. from W. Line

Ellis County

Location _____

Rig up _____

Drilling and Remarks:

8" @ 125
Ann 1251
Topoka 3048
Heb 3301
Lans 3347
Cong 3595
(over)

RECORD

Cased _____ in., _____ ft.

Sand _____

Gas _____

Oil _____

Total Depth 3687

PRODUCTION

1st 24 hrs. Nat. _____

1st 24 hrs. after shot _____

Gas _____ Cu. Ft.

Dry Hole _____

Abandoned _____

Date

JAN 25 1950

19

J. E. TYRA

Scout